

Fd Brass Cap
For W. 1/4 cor
Sec. 11

To 1/4 Cor. 2635.3 Platted
2631.73 Measured

1317.90 As per Plat
& E. RIDGEWAY

P.K. nails
610.25
608.90

2674.52'

Fd 2" Iron Pipe
Center of Sec 11
E 1/4 Cor Sec 11

set P-K nail

662.83

I set 4 - 1/2" x 24" Iron pins


Lots 4 & 5, Block 2
Newport Addition
to Hermiston Oregon

NE 7th

E. MAIN

Fd 2" dia Monu.

Fd 5/8 Iron pin

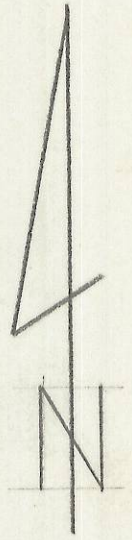

SCALE: 1" = 100'

2-22-73

In SEC. 11, T4N, R28E


RECEIVED BY

Umatilla County Surveyor

Date: 5/30/2013

Rec'd By: M.K.

No.: 13-164-A

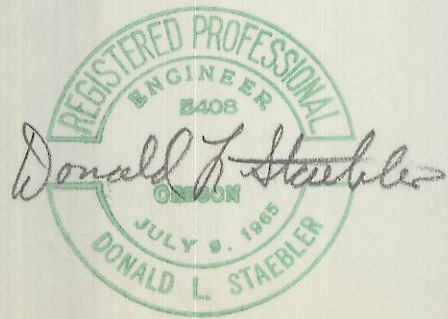

LOT SURVEY FOR
STAN GASS
HERMISTON OREGON

SCALE: 1" = 100' DATE: 2-22-73

DONALD L. STAEBLER
CONSULTING ENGINEER
P.O. BOX 91
PENDLETON, OREGON