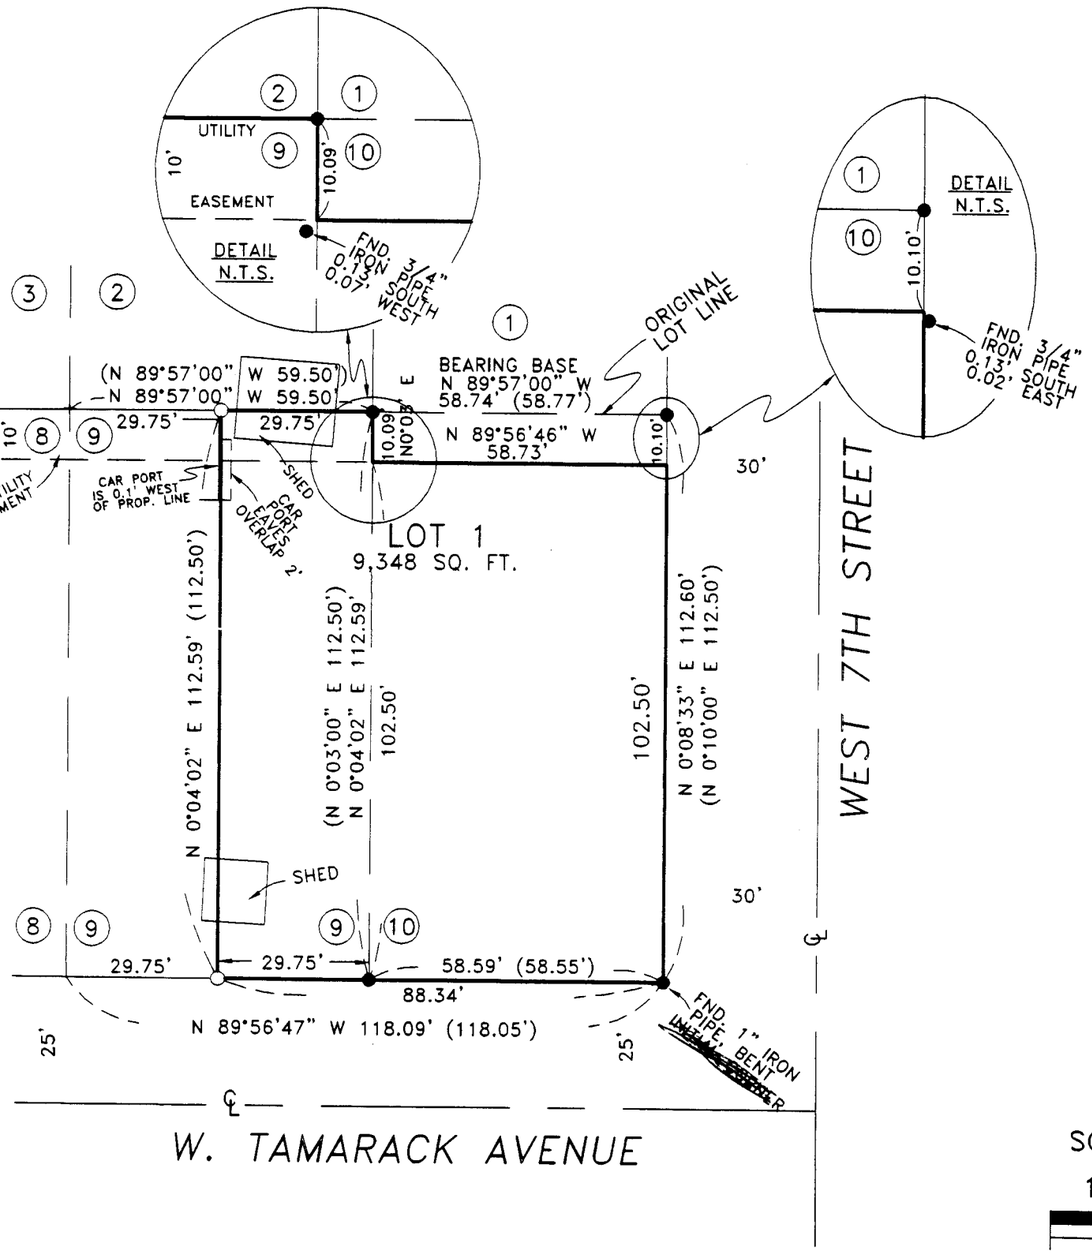

NARRATIVE:

THE PURPOSE OF THIS SURVEY IS TO

3/25/15
This 2000 survey was never completed and I just found out I had set the west corners. I am filing this map at this time.
G. Dennis Edwards

REGISTERED PROFESSIONAL LAND SURVEYOR

OREGON
JULY 16, 1971
G. DENNIS EDWARDS
9 5 1
RENEWS 12/31/2001

RECEIVED BY
Umatilla County Surveyor
Date: 4/2/2015
Rec'd By: CJ Hensley
No.: 15-022-PA

LEGEND:

- ● FOUND 1/2" IRON REBAR SET BY HAYES IN 1952, UNLESS NOTED OTHERWISE
- ○ SET 5/8"X30" IRON REBAR WITH PLASTIC CAP #951.

(000) OF RECORD 1952 PLAT OF "K" ADDITION

N

SCALE: 1"=30'

10 30
0 20 50

BOUNDARY LINE ADJUSTMENT
IN THE E 1/2, OF LOT 9 & THE SOUTH 102.5' OF LOT 10, "K" ADDITION, CITY OF HERMISTON,
IN SW 1/4, SECTION 10, T 4 N, R 28 E, W.M.,
UMATILLA COUNTY, OREGON
JOB# S0010209
EDWARDS SURVEYING P.O. BOX 763
541-567-3336 HERMISTON, OREGON 97838
DRAWN BY NJF