


# RECORD OF SURVEY for:

Dan Hill  
 1068 SW 17th Street  
 Hermiston, Oregon 97838  
 North 1/2 of SECTION 16,  
 Township 4 North, Range 28, East W.M.  
 Umatilla County, Oregon

**RECEIVED BY**  
 Umatilla County Surveyor  
 Date: 5/7/18  
 Rec'd By: CT  
 No.: 18-039-A

**NARRATIVE:**

The purpose of this survey was to re-establish some original lot corners for Dan Hill. This Survey is Based on the survey by Edwards for Dan Hill in 2002, C.S. 02-262-B. The Basis of Bearing was the North Line of that survey from both Edwards' & Cramer's found monuments. My North-South Center Line of Section 16 was Edward's record bearing from the found Center Quarter. I matched Edwards' record quite well along the North & East boundary so I set, reset, or show calculated corners locations based on Edwards previous Record of Survey as shown. This survey was performed with a Trimble RTK Total Station.

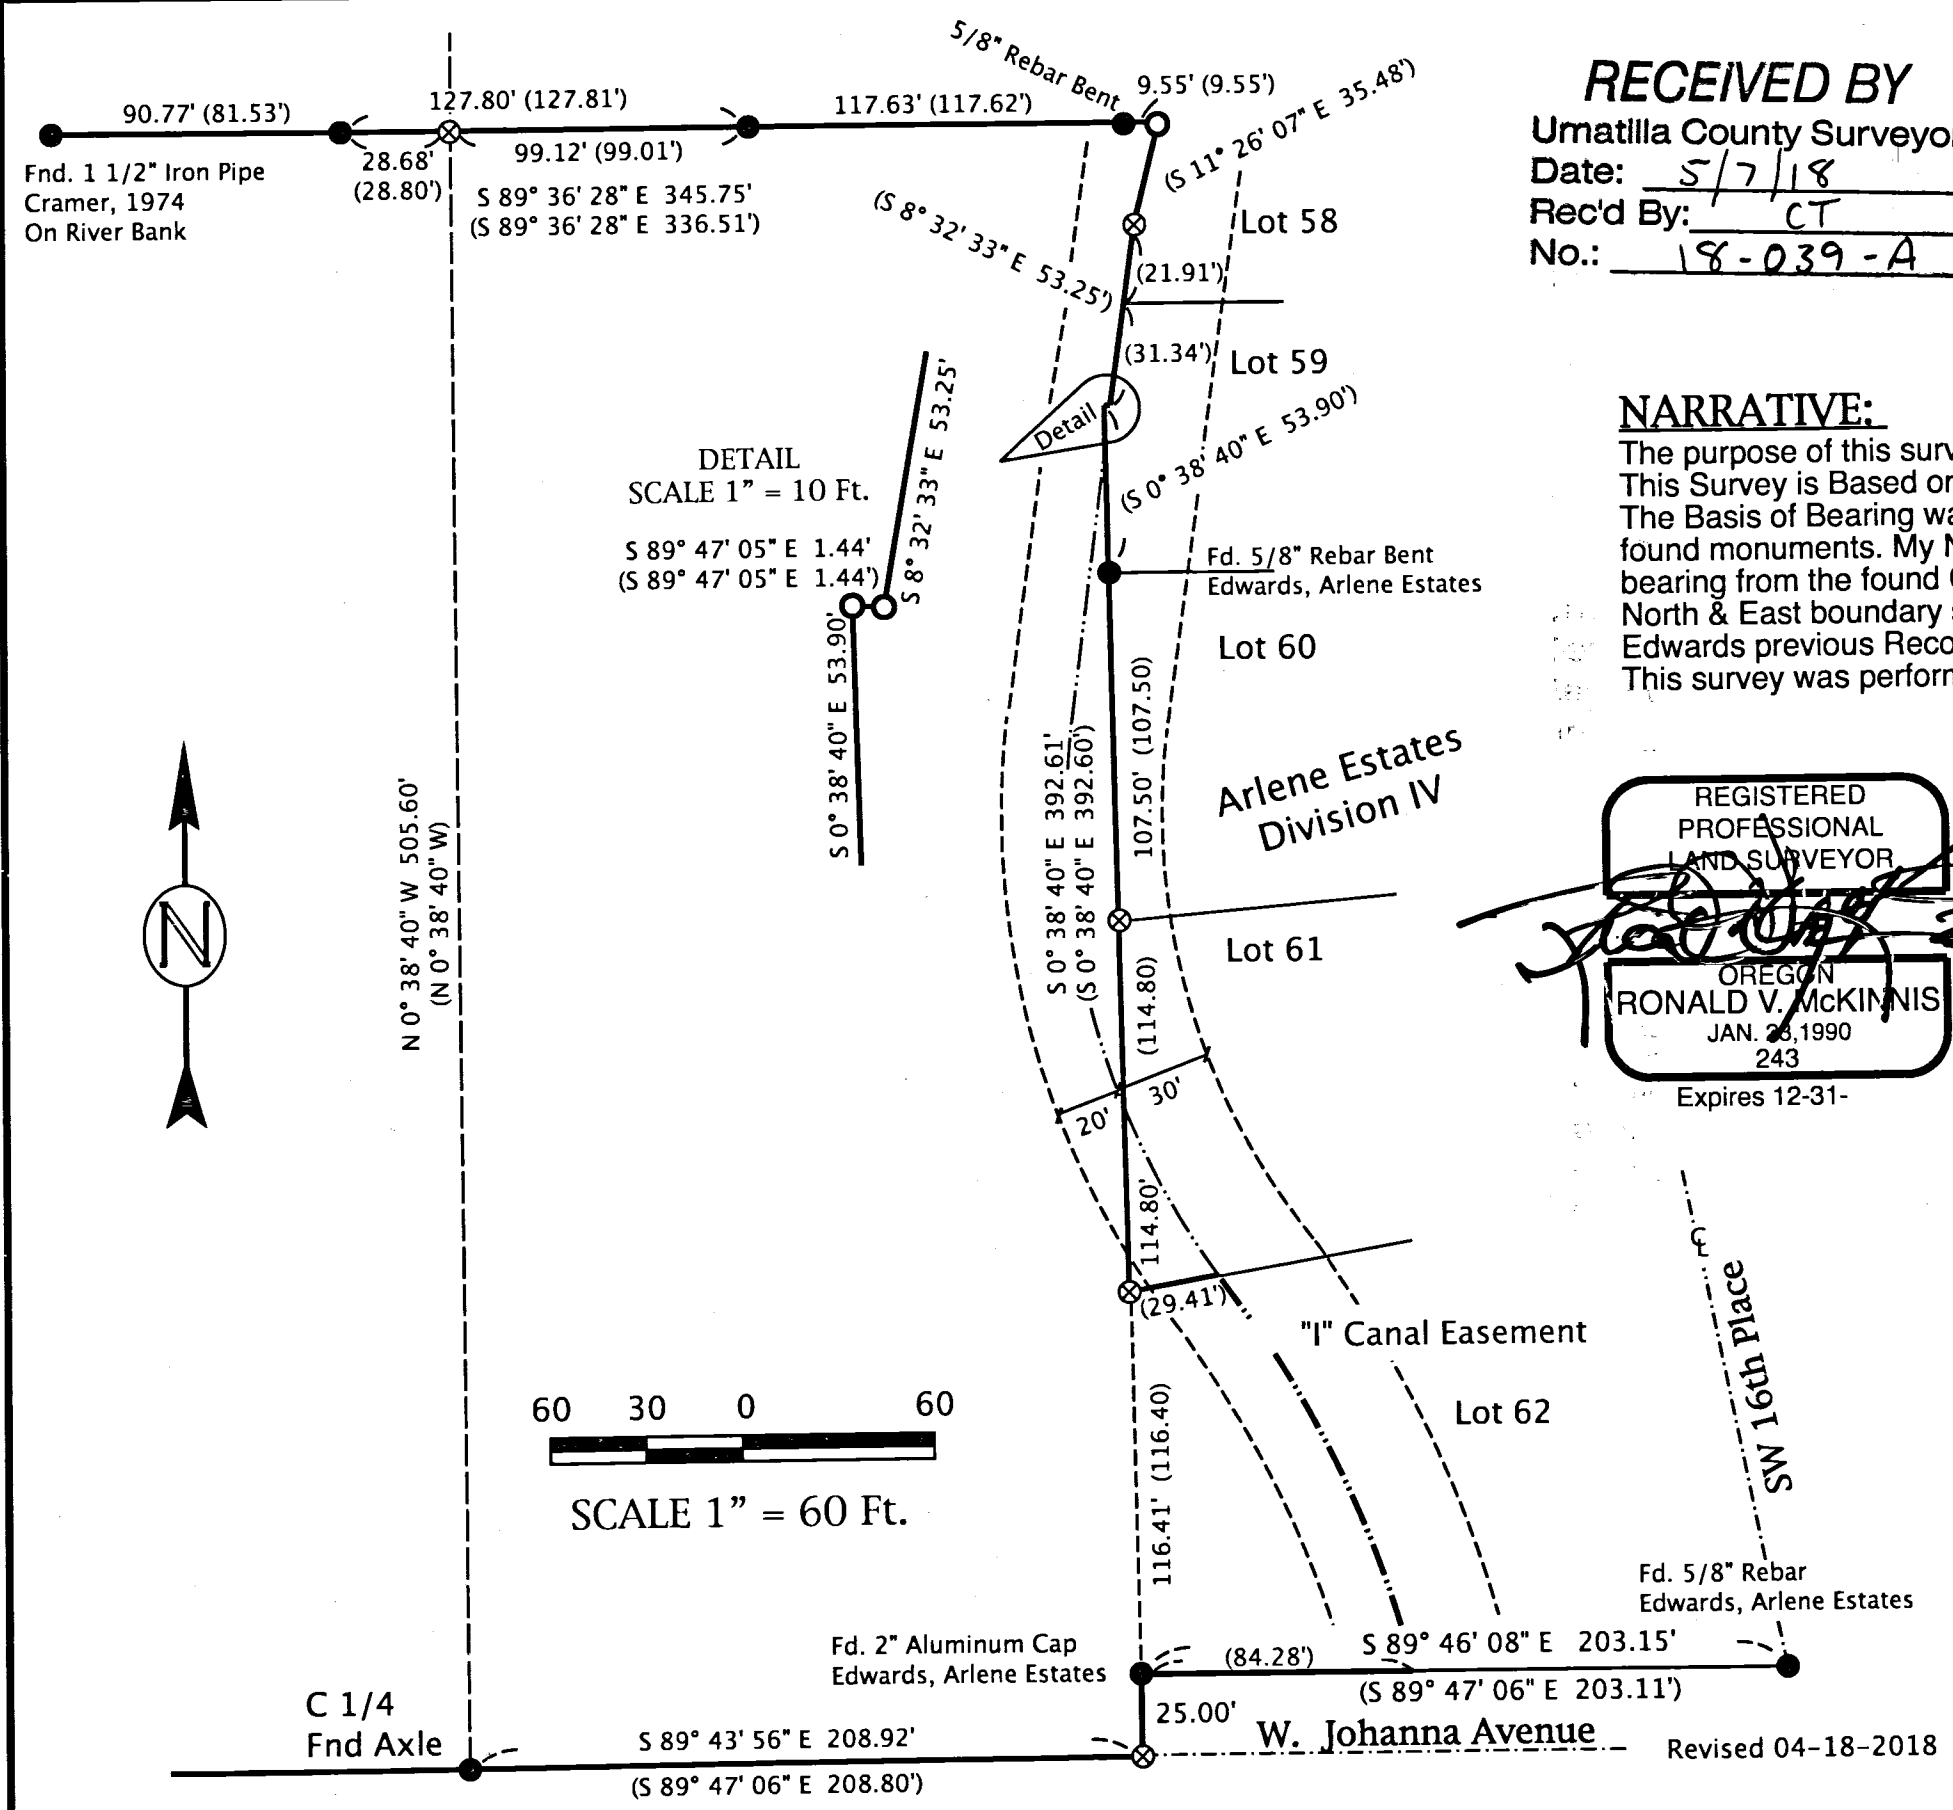

REGISTERED PROFESSIONAL LAND SURVEYOR  
  
 OREGON  
**RONALD V. MCKINNIS**  
 JAN. 28, 1990  
 243  
 Expires 12-31-

**LEGEND**

- Found Monument, 5/8" Rebar & Cap Edwards for Hill or as Noted
- Set 5/8" x 30" Rebar W/ Plastic Cap, PLS #2431
- ⊗ CALCULATED POINT - Not Set
- C.L. STREETS
- TRACT BOUNDARIES
- (000) Record - Edwards for Hill, 02-262-B

April, 2018

ENGINEERING - LAND SURVEYING - WATER RIGHTS  
**R. V. MCKINNIS ENGINEERING**  
 79980 Prindle Loop Road  
 Hermiston, Oregon 97838  
 (541) -567-2017

Revised 04-18-2018