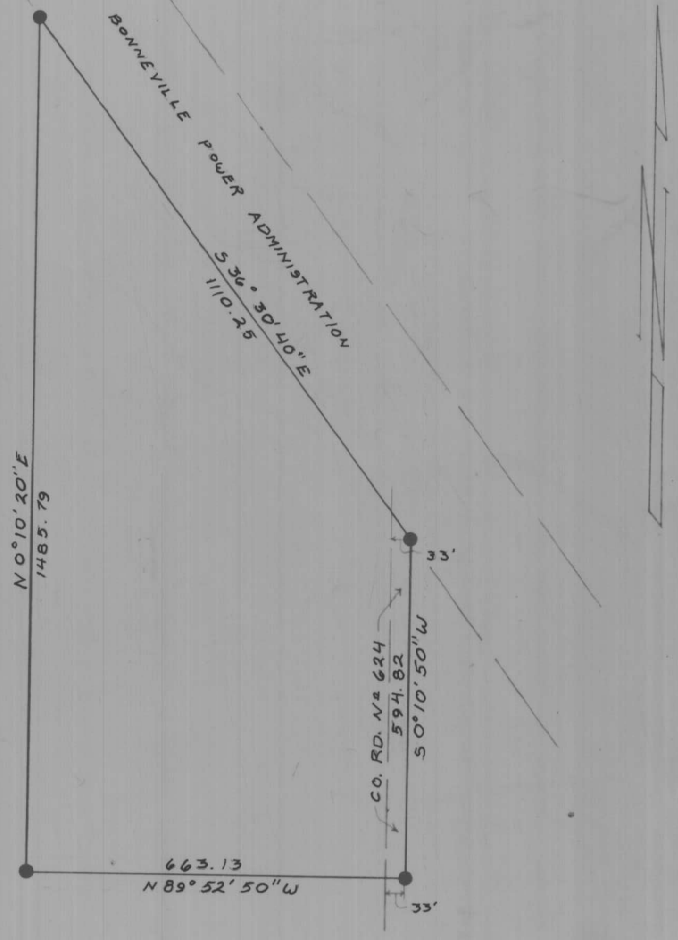

DETAIL
SCALE 1" = 200'

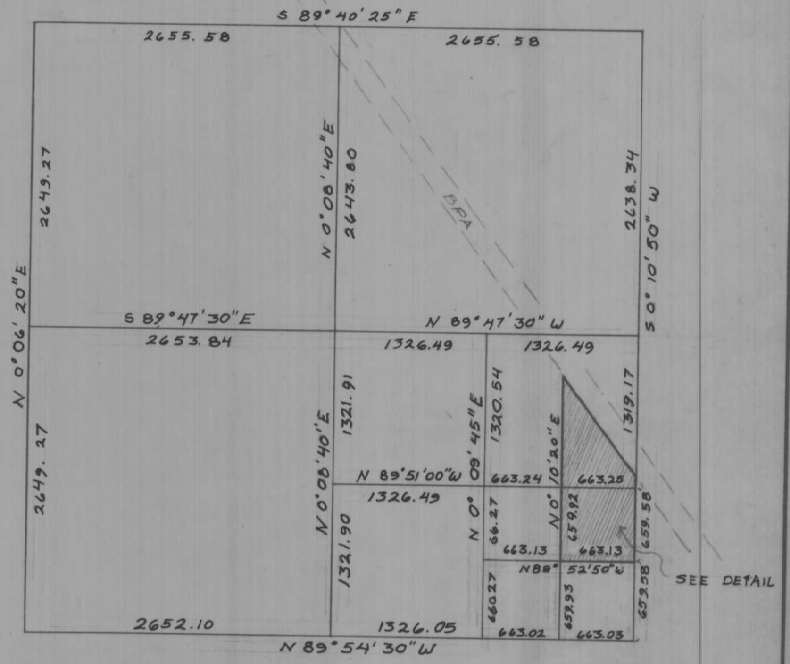

SEC. 27, T5N, R28E
SCALE 1" = 1000'

● SET 1/2" IRON PIN

NOTE: BEARINGS ARE BASED UPON TIES TO N.G.S. STATION HERMISTON BUTTE. THOSE SHOWN ARE TRUE.

REGISTERED PROFESSIONAL LAND SURVEYOR
David H. Kumbein
OREGON
DAVID H. KUMBEIN
933

I-28-A

SURVEY FOR	WAYNE HARRIS CO. INC.				
PRIDE - PAK	ENGINEERS - SURVEYORS PENDLETON, ORE.				
SECTION 27, T5N, R28E	SCALE	AS SHOWN	DRN. BY	J M B	DRN. NO.
	DATE	4-30-74	CKD. BY	D H K	74-272-A

I-28-A