


Survey for Warren McConnell in
 Block 71 Wardwell's Add. to City of
 Umatilla, Umatilla County, Ore. NW⁴ Sec 17, T5N, R28E, W.M.
 9/8/75 Denny Edwards P.O. Box 805
 Hermiston

Scale 1" = 50'
 ○ 1/2 I.Rods set
 (000) of record

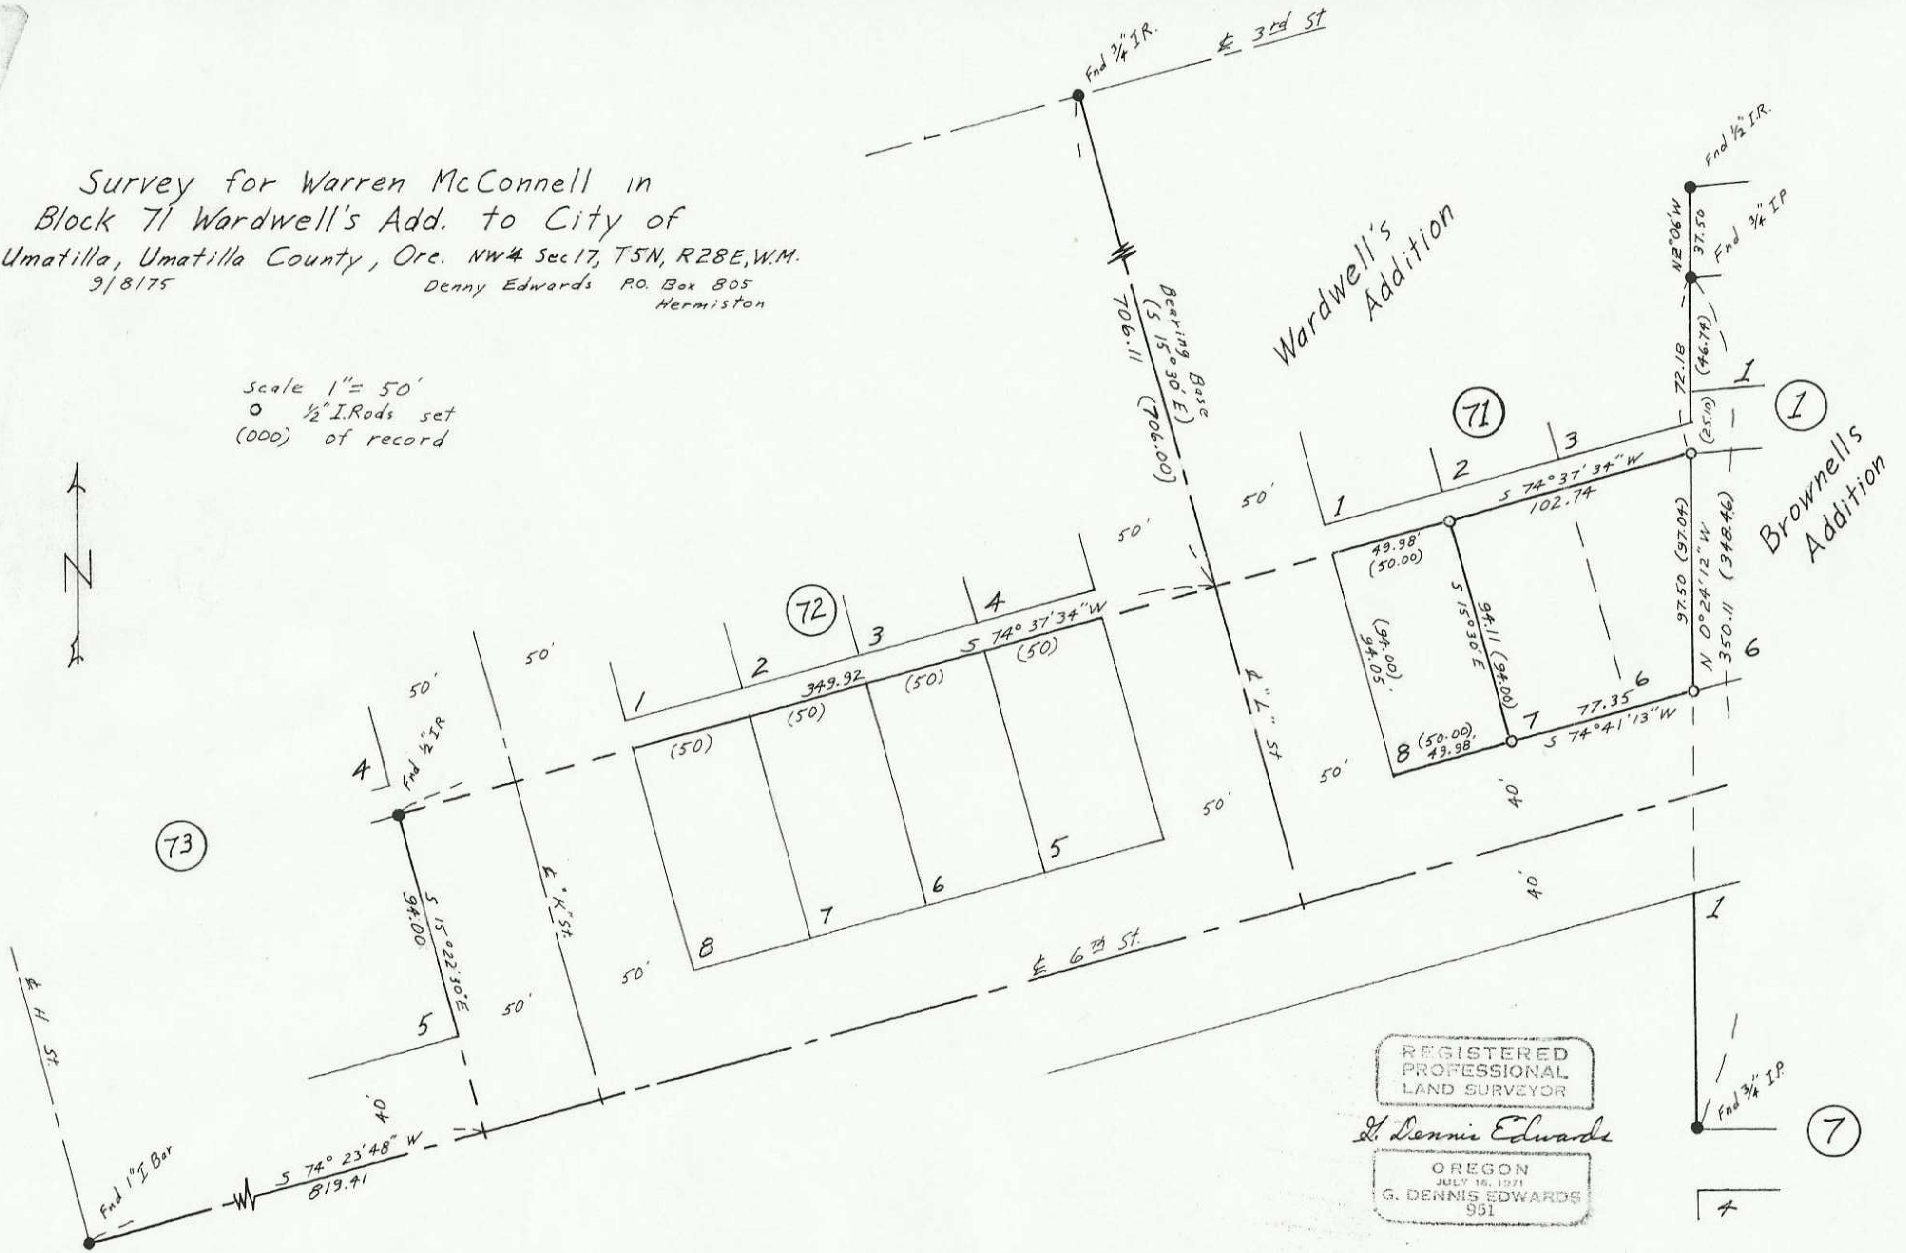

REGISTERED
 PROFESSIONAL
 LAND SURVEYOR
 G. Dennis Edwards
 OREGON
 JULY 18, 1971
 G. DENNIS EDWARDS
 991

J-16-A