

FND. 5/8" I.R.  
SE. COR. NE. 1/4, NW. 1/4, NW. 1/4, SEC. 15

UNPLATTED

**CERTIFICATION**

I, G. DENNIS EDWARDS, A REGISTERED PROFESSIONAL LAND SURVEYOR HEREBY CERTIFY THAT ON 6/30/75 A SURVEY WAS STARTED AND COMPLETED ON 7/1/75 OF THE LANDS SHOWN HEREON BY ME OR UNDER MY DIRECTION, THAT THE PROPERTY CORNERS ARE MARKED AS SHOWN, AND THAT THIS MAP IS A TRUE AND ACCURATE REPRESENTATION OF SAID SURVEY.

( FOR DESCRIPTION SEE ATTACHED SHEET )

REGISTERED  
PROFESSIONAL  
LAND SURVEYOR

*G. Dennis Edwards*

OREGON  
JULY 16, 1971  
G. DENNIS EDWARDS  
951

**LEGEND**


- PROPERTY LINE
- CENTER LINE
- RIGHT OF WAY LINE
- 1/2" IRON ROD

SCALE 1" = 30'

SE. 1/4, NW. 1/4, NW. 1/4, SEC. 15, T.4N., R28E., W.M.

SURVEY FOR	HERMISTON REALTY	
<b>GASCHLER &amp; ASSOCIATES</b>		
ONTARIO, OREGON		HERMISTON, OREGON
DESIGNED BY:	DRAWN BY: <i>J. G.</i>	APPROVED BY:
DATE: 7/1/75	DRAWING NO. A-3	BK _____ PG _____
SHEET 1 OF 1	JOB NO. HSO-0375	REVISED:

J-019-A

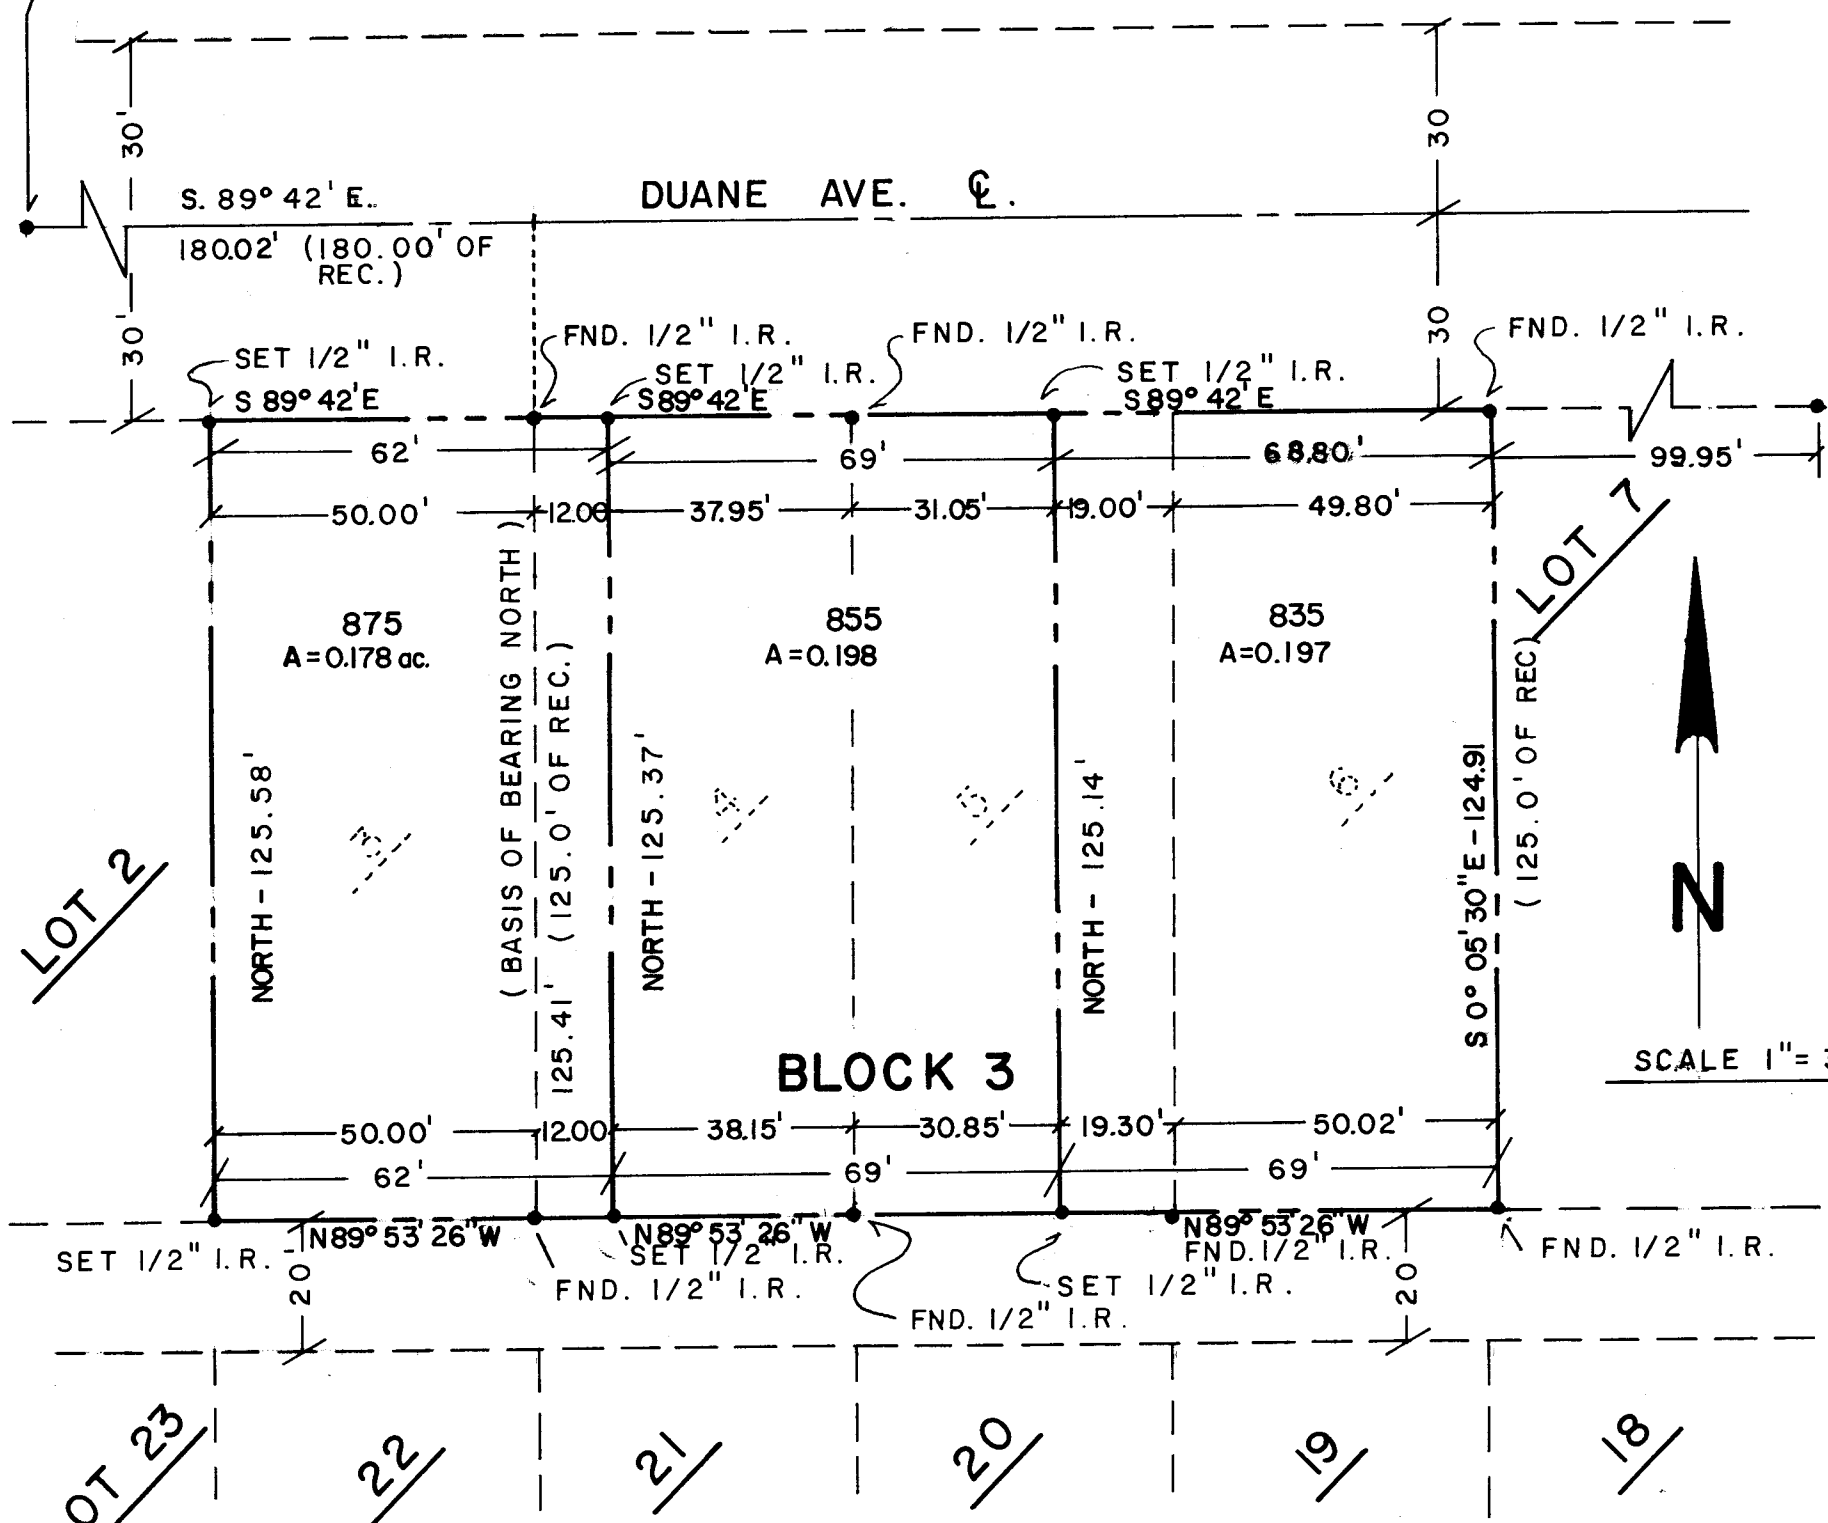

34 N. OREGON ST  
P. O. BOX 412  
ONTARIO, ORE. 97914  
(503) 889-3008

**GASCHLER & ASSOCIATES**  
CIVIL ENGINEERING CONSULTANTS

RECLAMATION BLDG.  
P. O. BOX 829  
HERMISTON, ORE. 97838  
(503) 567-3336

July 2, 1975  
Hermiston

Hermiston Realty Co.  
Hermiston, Oregon

Re: Property description for lots No. 835, 855, 875 formed from  
Lots 3, 4, 5, 6 of Block 3 of the Lathrop Addition to the  
City of Hermiston

Lot No. 835

This lot is described as being that parcel of land which includes  
all of Lot 6 and the East nineteen (19) feet of Lot 5, Block 3 of  
the Lathrop Addition to the City of Hermiston as shown on the  
official Subdivision Plat, Umatilla County, Oregon


Lot No. 855

This lot is described as being that parcel of land which includes  
the West thirty-one (31) feet of Lot 5 and the East thirty-eight  
(38) feet of Lot 4, Block 3 of the Lathrop Addition to the City of  
Hermiston as shown on the official Subdivision Plat, Umatilla  
County, Oregon

Lot No. 875

This lot is described as being that parcel of land which includes  
the West twelve (12) feet of Lot 4 and all of Lot 5, Block 3 of  
the Lathrop Addition to the City of Hermiston as shown on the  
official Subdivision Plat, Umatilla County, Oregon

Legal survey of the above described lands was completed on July 1,  
1975 and the attached survey plat is a true representation of  
said survey of these lands

  
G. Dennis Edwards  
Reg. Prof. Land Surveyor