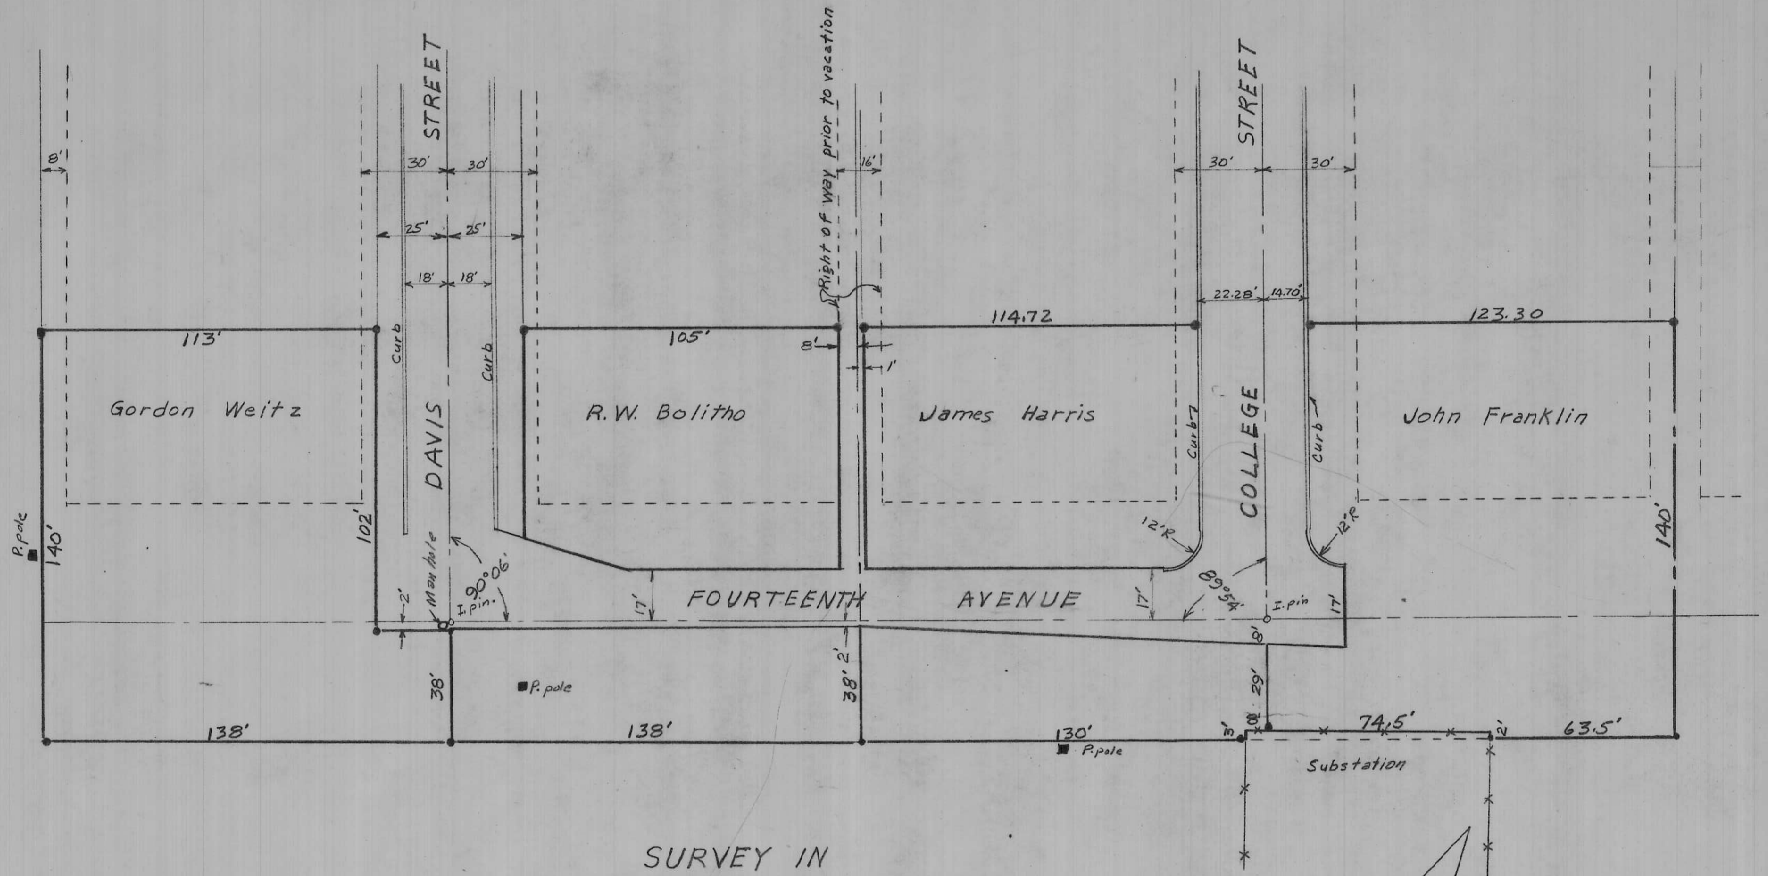

SURVEY IN
HILLSIDE ADDITION
MILTON-FREEWATER, ORE.
Scale 1"=50' Aug. 24, 1975

REGISTERED PROFESSIONAL ENGINEER
4813
OREGON
JAN. 12, 1962
GUY W. STREAMER, JR.
Guy W. Streamer Jr.

J-75-A Survey 794