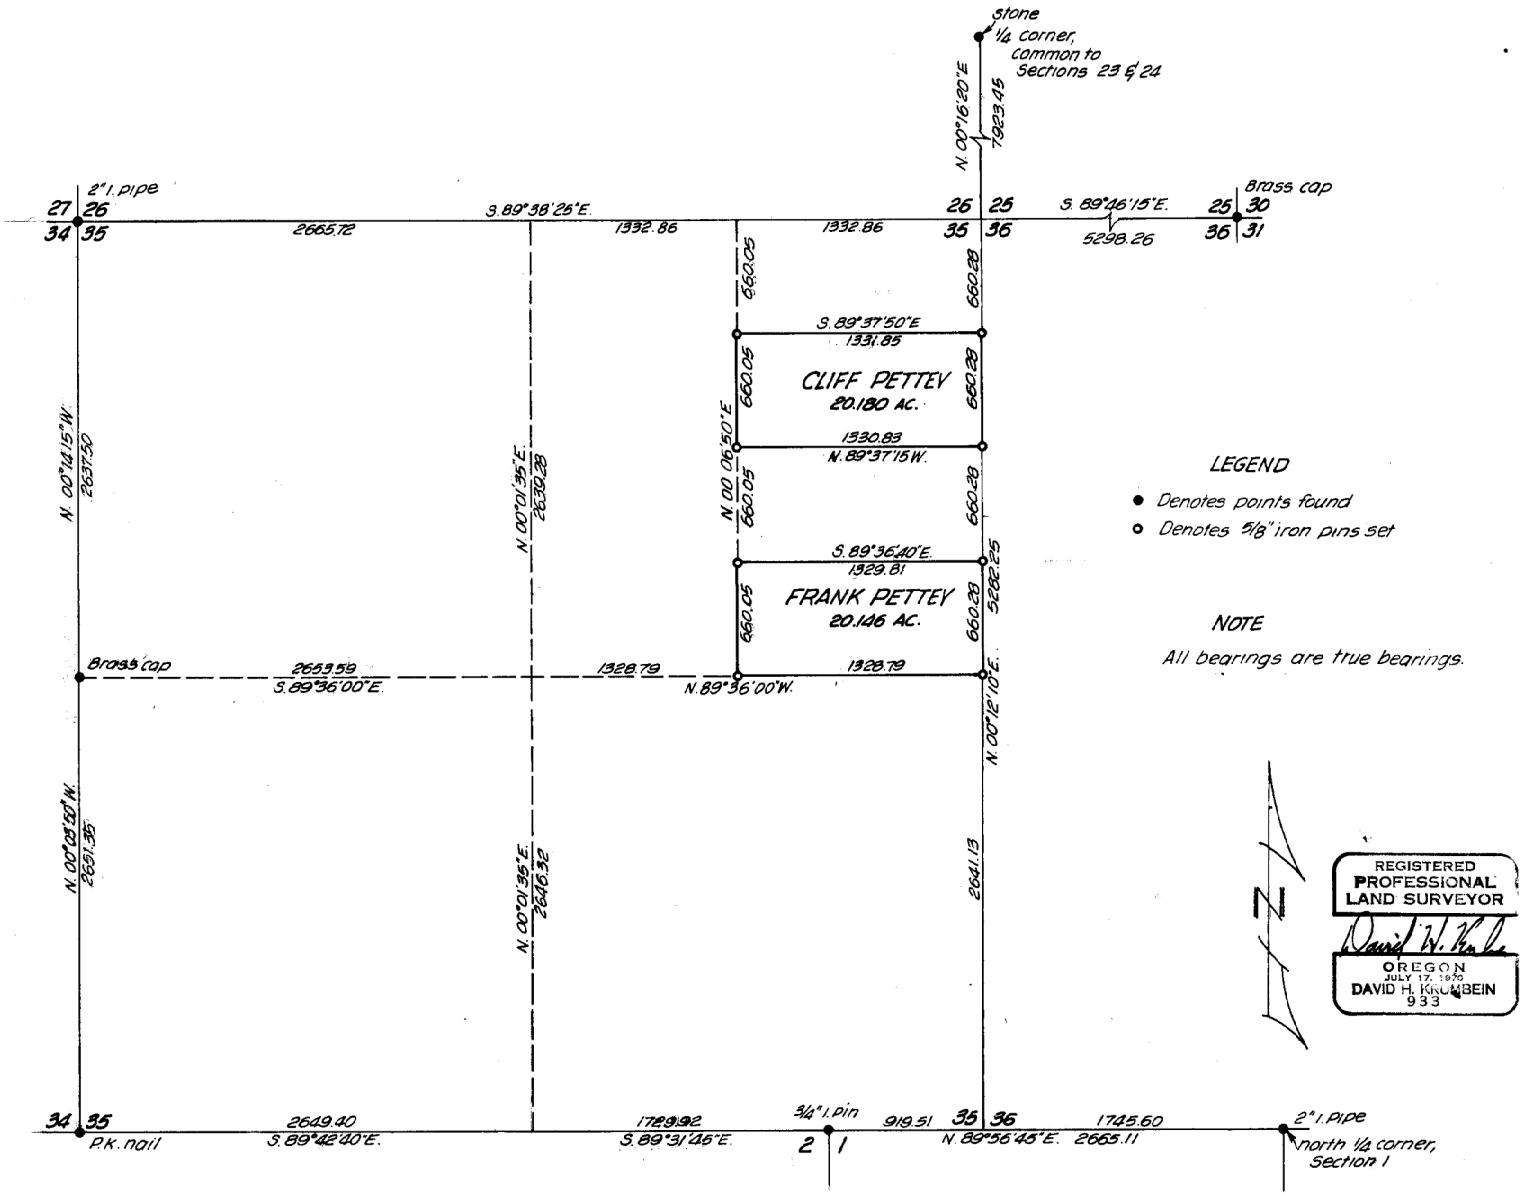

J-94-A

Plat of survey for CLIFF and FRANK PETTEY situated in Sec 35, T. 5 N., R. 28 E., W.M., Umatilla Co., Oregon

WAYNE HARRIS CO., INC.
SURVEYORS-ENGINEERS PENDLETON, ORE.

SCALE	1"=600'	DRGN BY	C.T.P.	DRGN NO.
DATE	5-12-75	CK'D BY	D.H.K.	75-60B