


SECTION

SECTION

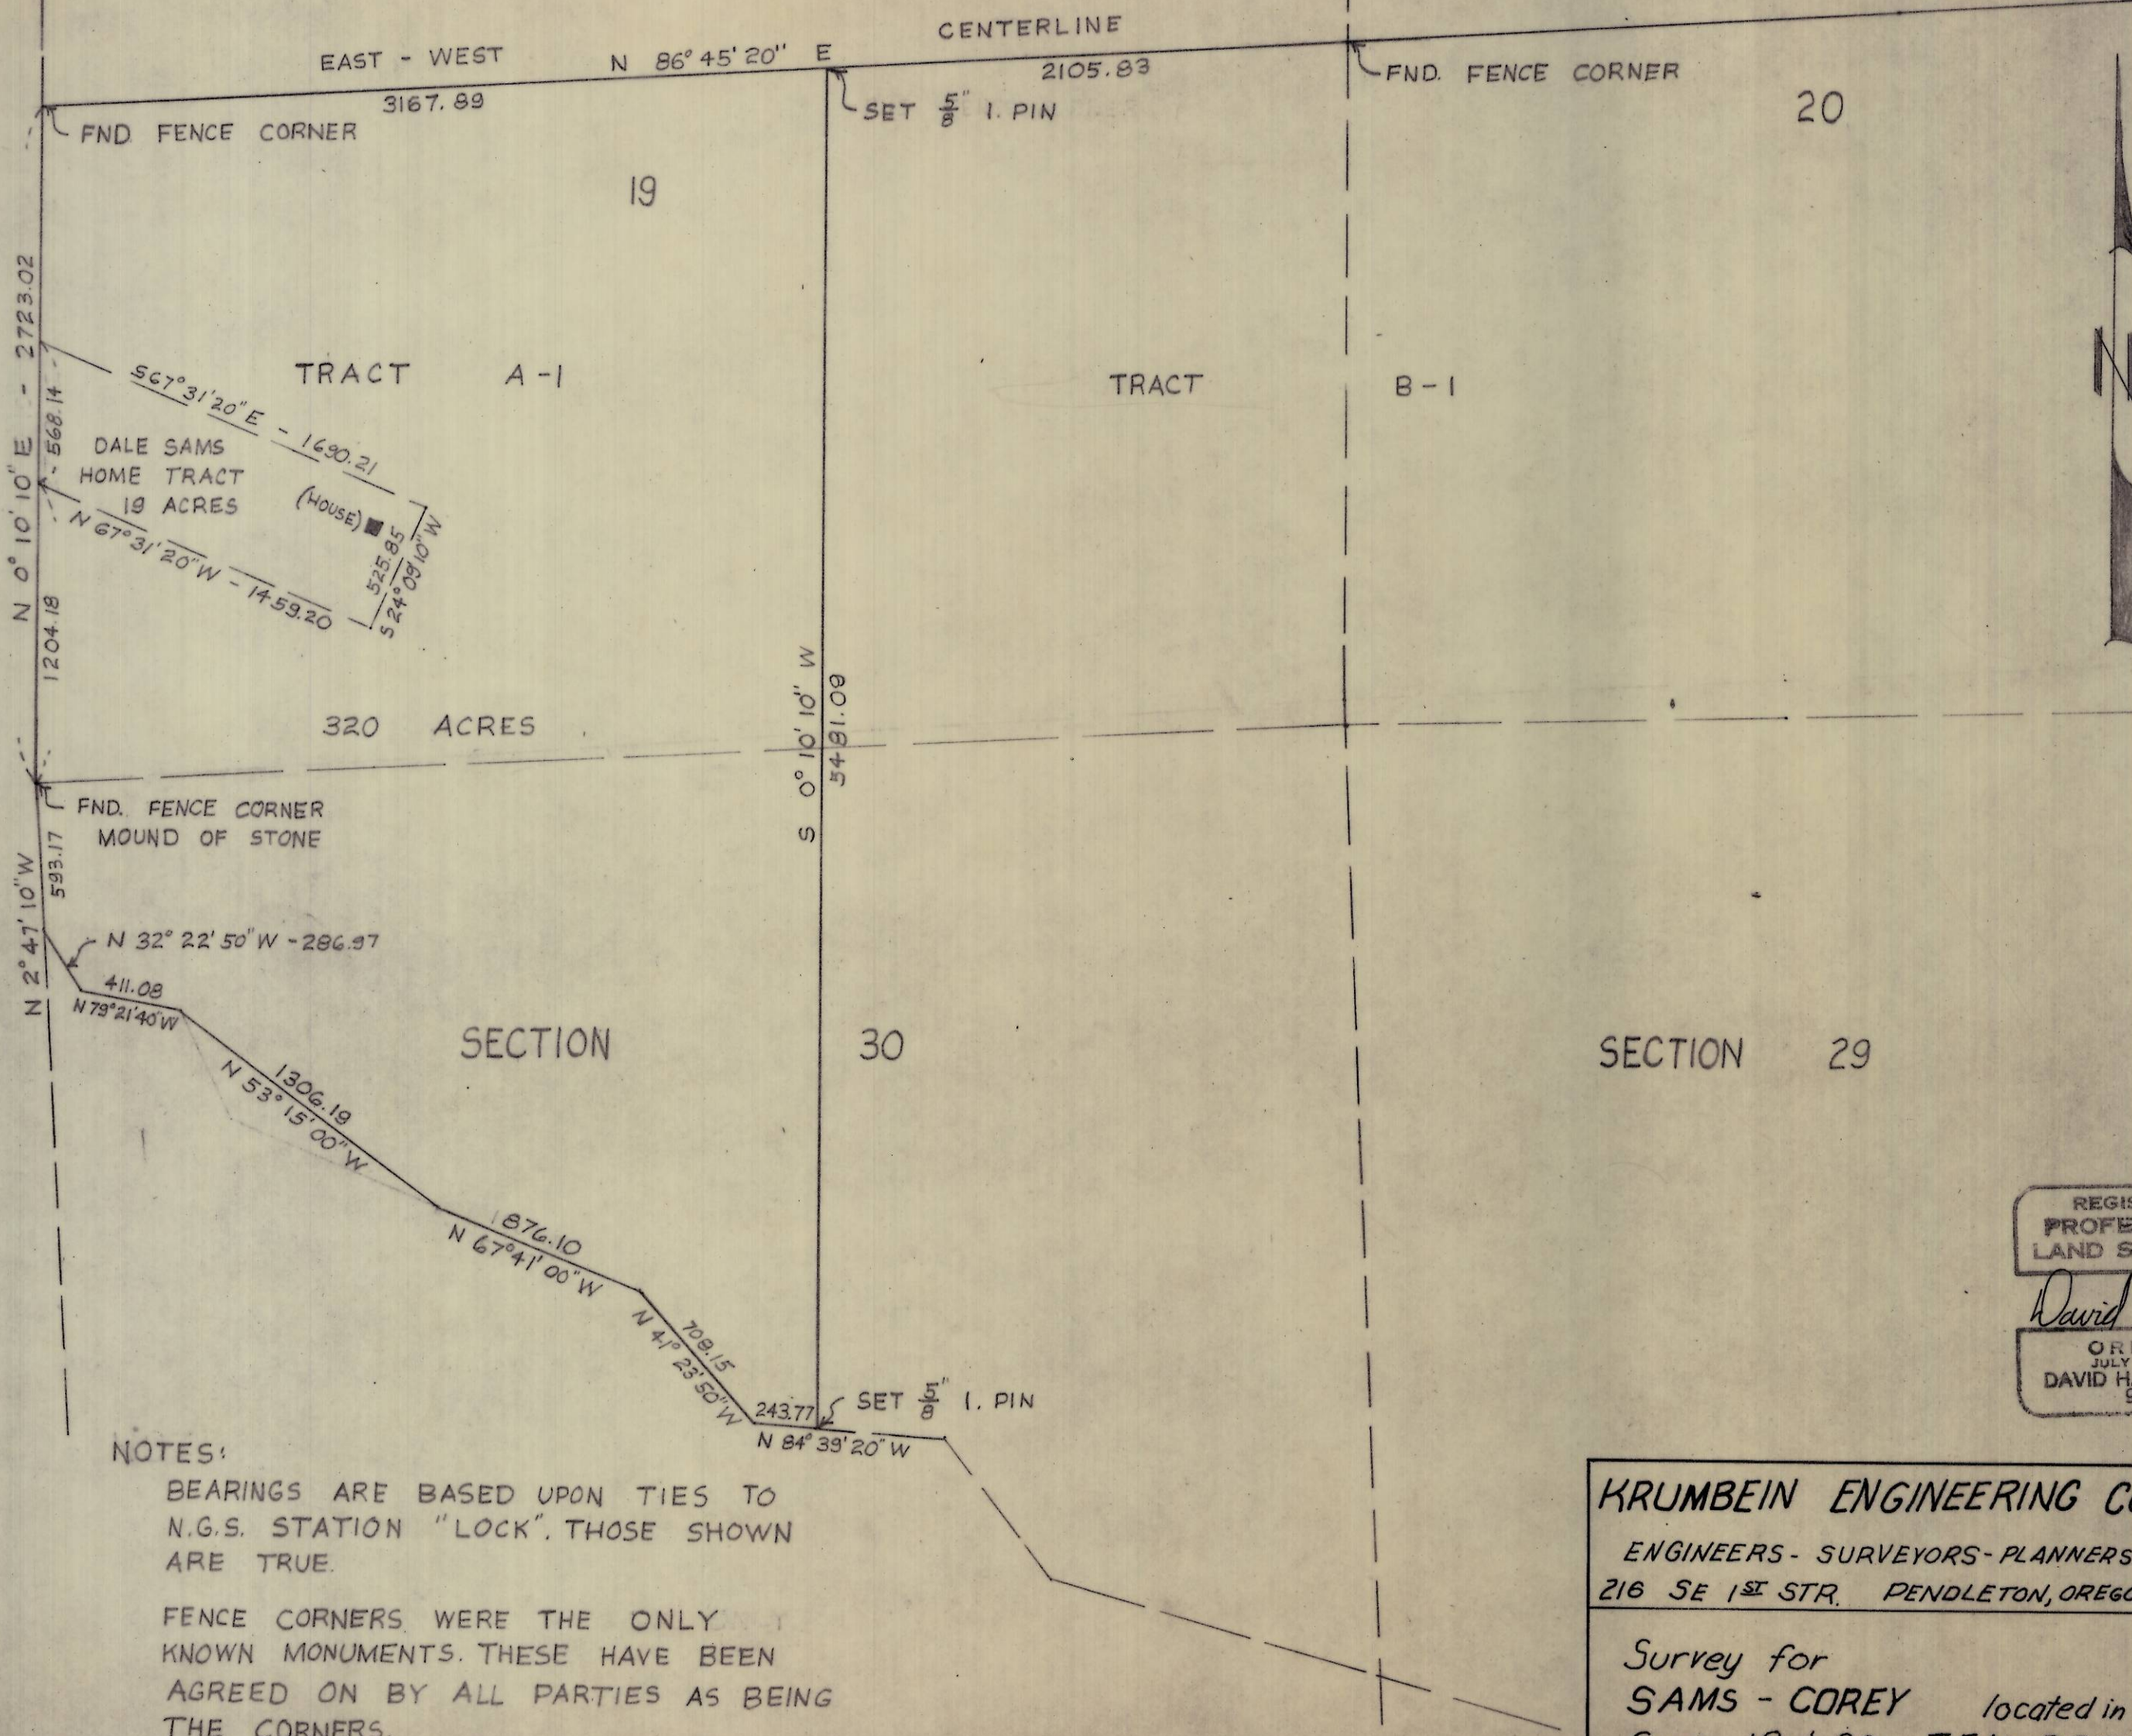

NOTES:  
 BEARINGS ARE BASED UPON TIES TO N.G.S. STATION "LOCK". THOSE SHOWN ARE TRUE.  
 FENCE CORNERS WERE THE ONLY KNOWN MONUMENTS. THESE HAVE BEEN AGREED ON BY ALL PARTIES AS BEING THE CORNERS.

REGISTERED PROFESSIONAL LAND SURVEYOR  
*David H. Krumbein*  
 OREGON  
 JULY 17, 1970  
 DAVID H. KRUMBEIN  
 933

J-152-A

<b>KRUMBEIN ENGINEERING CO</b>	SCALE
	1" = 600'
ENGINEERS - SURVEYORS - PLANNERS	DATE
216 SE 1 <sup>ST</sup> STR. PENDLETON, OREGON	11-5-75
Survey for <b>SAMS - COREY</b> located in Secs. 19 & 30 T.5N, R.37E.	DRN. BY
	DHK
	CKD. BY
	JLC
	DRNG. NO.
	75-78

J-152-A