

BASIS OF BEARING

SOLAR OBSERVATION
 NW CORNER, SECTION 3
 NOVEMBER 21, 1975
 LATITUDE: 45° 10' 24"
 DECLINATION: 19° 52' 59.1" S
 VERTICAL ANGLE: 16° 24' 26"
 MEAN MAGNETIC
 DECLINATION: 19° 30' E

DESCRIPTION OF FOREST SERVICE LANDS

SECTION 3
 S 1/2
 NW 1/4
 S 1/2 OF THE NE 1/4


NOTE

FOR REMONUMENTATION RECORDS, SEE
 REMONUMENTATION SHEETS FILED SEPARATELY.

SURVEYOR'S STATEMENT

I, DUANE I GRIFFITH, REGISTERED LAND SURVEYOR IN THE STATE OF OREGON, HEREBY CERTIFY THAT THIS PLAT AND THE NOTES HEREON, OR ATTACHED, ARE A CORRECT REPRESENTATION OF THE SURVEY I MADE DURING OCTOBER AND NOVEMBER, 1975, FOR THE U.S. FOREST SERVICE, IN ACCORDANCE WITH THE STATUTES OF THE STATE OF OREGON AND WITH THE ARTICLE OF MY CONTRACT.

Duane I. Griffith
 PLS 644

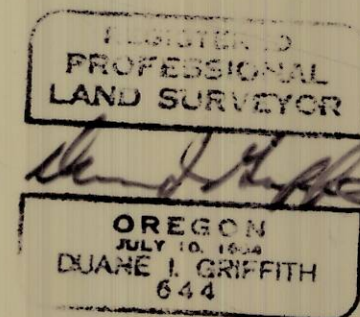

LEGEND

- FOUND G.L.O. CORNER SET 2 1/2" x 30" IRON PIPE WITH BRASS CAP.
- ⊙ SET 2 1/2" x 30" IRON PIPE WITH BRASS CAP AT PROPORTIONATE DISTANCE.
- () RECORD BEARING AND DISTANCE.
- 123 m METRIC EQUIVALENT
- FOREST SERVICE BOUNDARY
- P PRIVATELY OWNED LANDS

BAGETT, GRIFFITH & ASSOCIATES

La Grande, Oregon		
Map of Survey		
SECTION 3		
T 5 S, R 33 E, W M		
UMATILLA COUNTY, OREGON		
SURVEYED FOR	UMATILLA NATIONAL FOREST	
SURVEYED BY	D. I. G.	NOV. 1975
Scale: 1" = 600'	Drawn by: t.d.g.	DEC. 1975

K-12-A

K-12-A