


*description as to  
the plat*

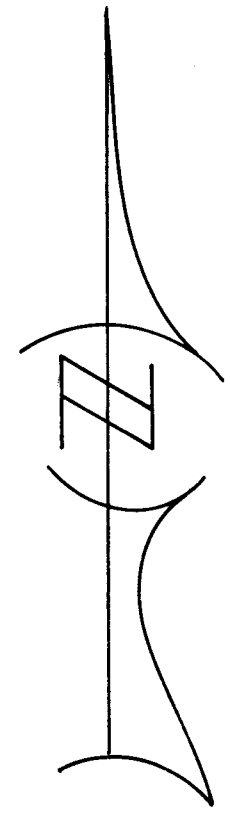

BEARINGS BASED ON OCT. '75  
 SURVEY DONE BY GASCHLER &  
 ASSOCIATES IN NW 1/4 OF SEC.5,  
 T4N, R29E, W.M.

M-001-A

**REGISTERED  
 PROFESSIONAL  
 LAND SURVEYOR**

*G. Dennis Edwards*

**OREGON  
 JULY 16, 1971  
 G. DENNIS EDWARDS  
 951**

**SURVEY FOR MELVIN RAY**

**LOCATION: NW 1/4 OF  
 SEC. 5 , T 4 N, R 29 E, W.M., UMATILLA COUNTY, OREGON**

**DATE: 10-28-76** **SCALE: 1" = 200'**

● 5/8" IR. MONUMENTS FOUND **(000) OF RECORD**

○ 1/2" IRON RODS SET **JOB NO. S7610281**

**EDWARDS SURVEYING  
 567-3336**

**P. O. Box 763  
 Hermiston, Ore.**