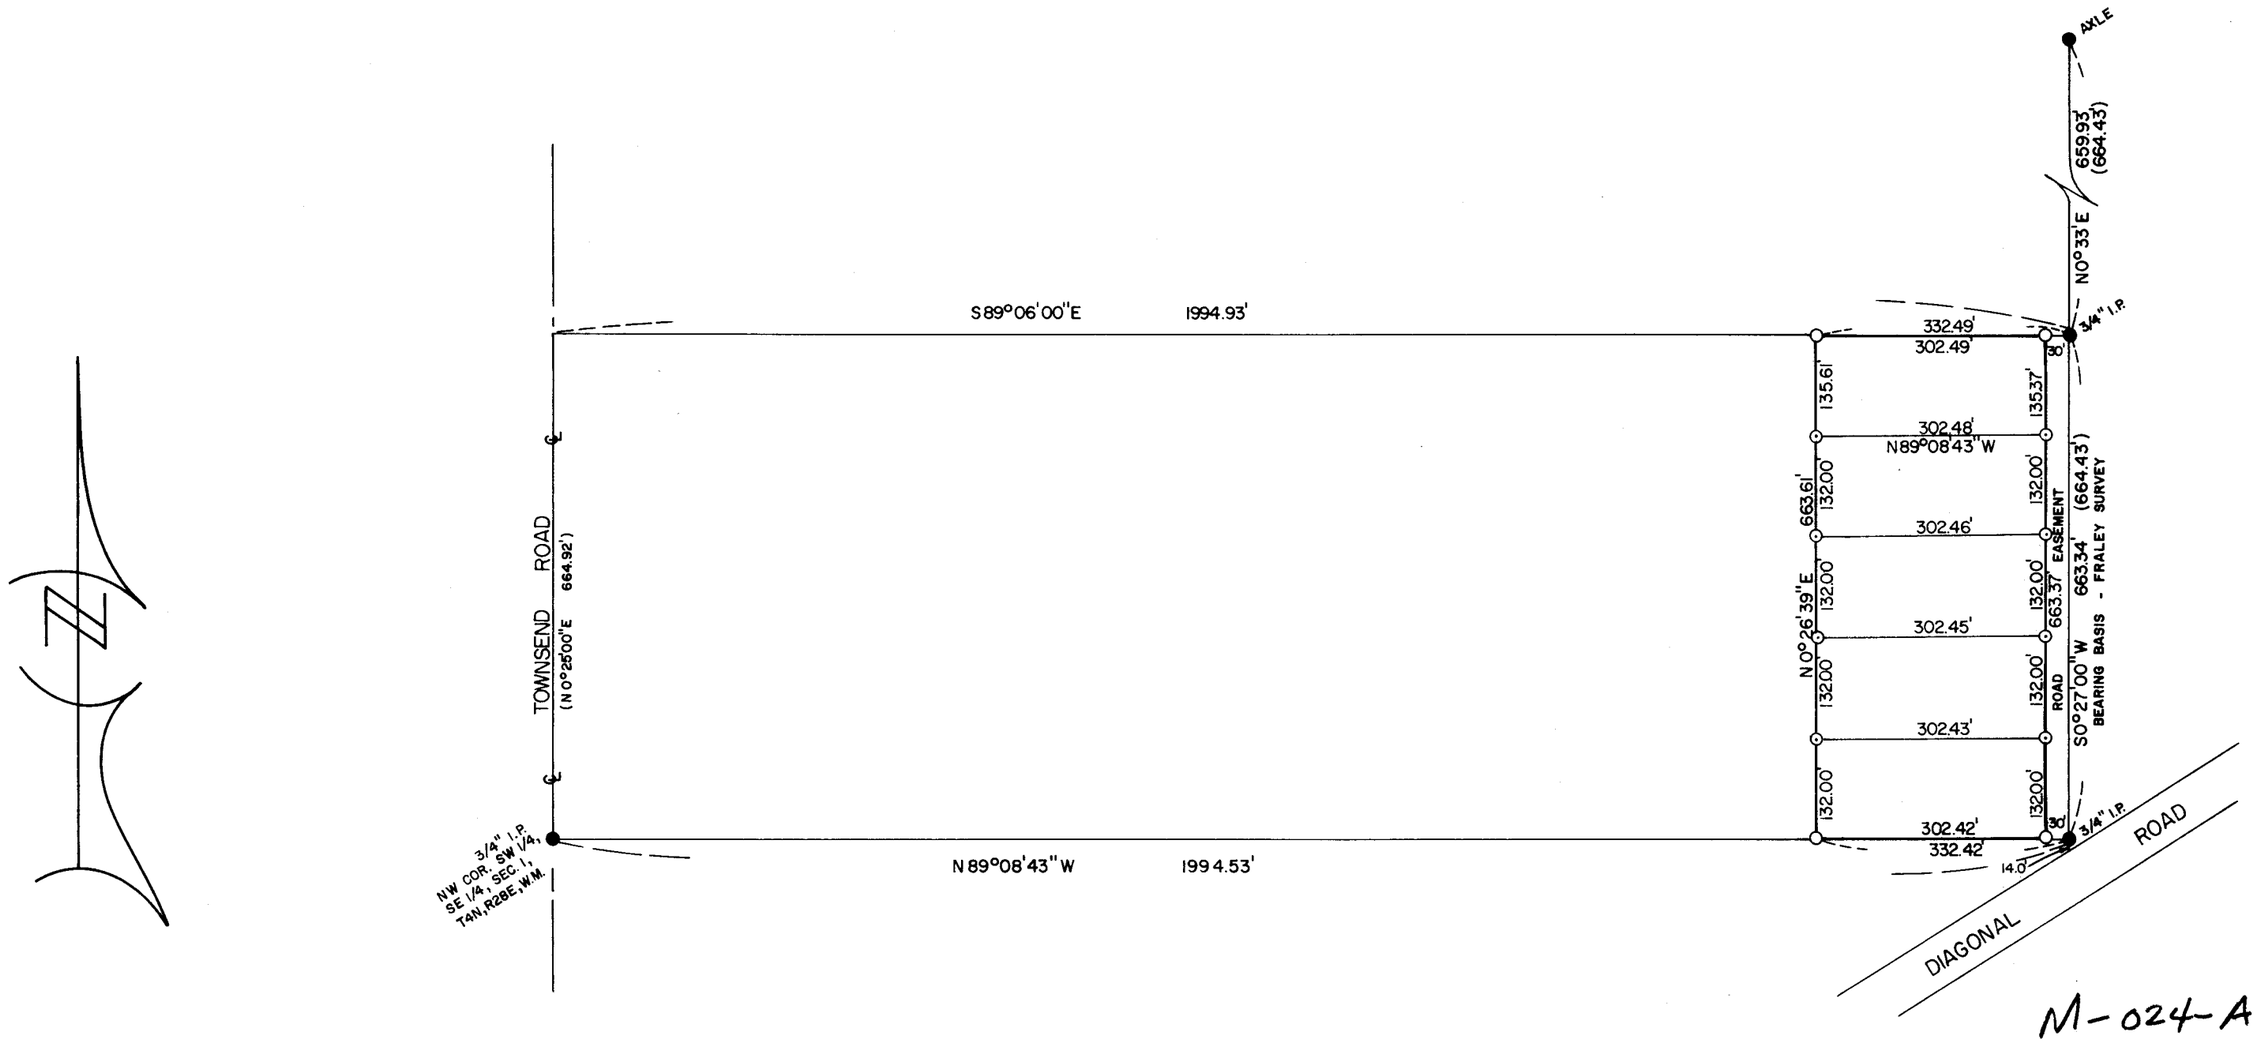

M-024-A

REGISTERED PROFESSIONAL LAND SURVEYOR

G. Dennis Edwards

OREGON
JULY 16, 1971
G. DENNIS EDWARDS
951

SURVEY FOR **BILL ROFF**

LOCATION: SE 1/4 OF

SEC. 1, T 4 N, R 28 E, W.M., UMATILLA COUNTY, OREGON

DATE: 10-22-76 | SCALE: 1" = 200'

● MONUMENTS FOUND | (000) OF RECORD

⊙ 1/2" I.R. SET 12-26-76

○ 1/2" IRON RODS SET | JOB NO. S7610271

EDWARDS SURVEYING
567-3336

P. O. Box 763
Hermiston, Ore.

REVISED: 12-26-76 | REVISION: SET 1/2" IRON RODS ⊙