


60.06 ACRES

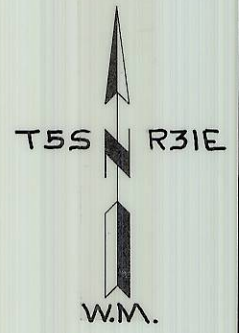

**LEGEND**

- SET 5/8" STEEL PIN WITH CAP MARKED AP & A
- PROPERTY LINE
- \* - - - \* RIGHT-OF-WAY FENCE

NOTE: THIS SURVEY IS BASED ON SPLITTING THE R/W FENCES TO ESTABLISH THE & OF COUNTY ROAD NO. 381

**BASIS OF BEARING**

EAST-WEST & OF COUNTY RD. NO. 381 AS N 90° 00' 00" E



<b>PROPERTY SURVEY</b>		
SOUTH 1/2 SEC. 13, T5S, R31E, W.M.		
FOR: CITY OF UKIAH		
SCALE:	 <b>anderson perry</b> & associates, inc. <small>engineering • surveying • materials testing</small> LA GRANDE & ENTERPRISE, OREGON	SHEET NO.
1" = 20'		
DATE:	1977	