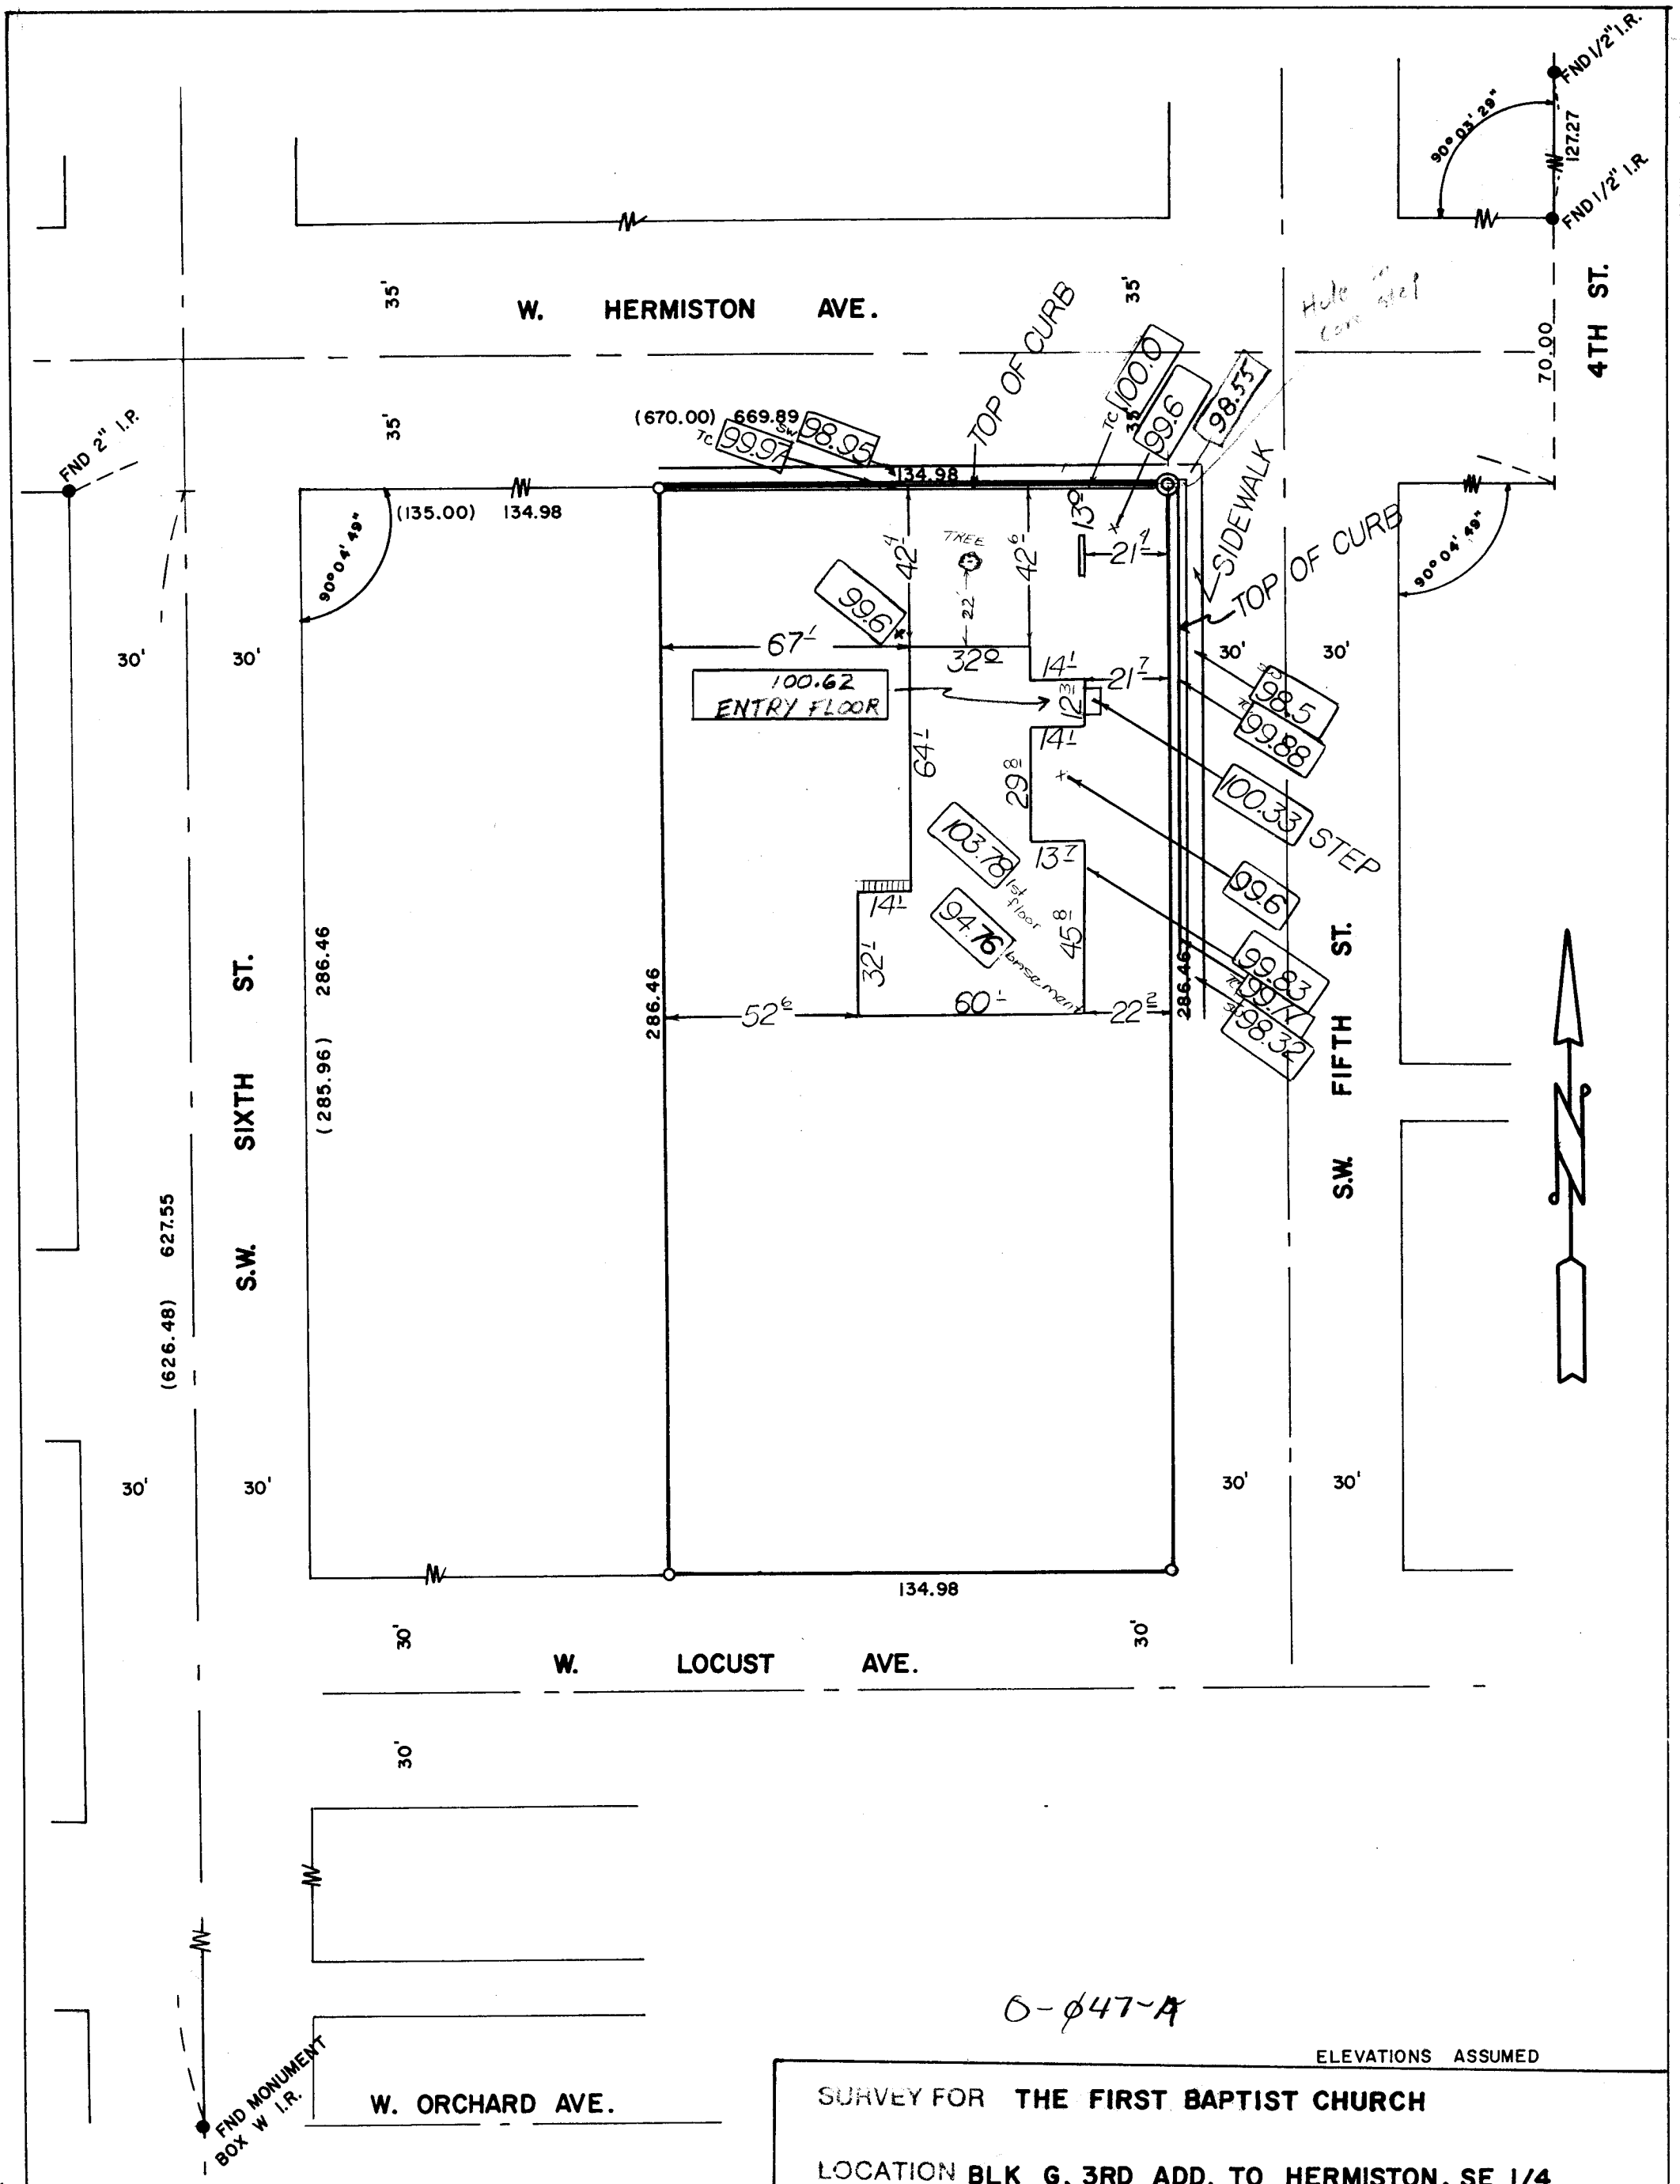

0-047-A

ELEVATIONS ASSUMED

SURVEY FOR **THE FIRST BAPTIST CHURCH**

LOCATION **BLK G, 3RD ADD. TO HERMISTON, SE 1/4**

SEC. **10** , T **4** N, R **28** E, W.M., UMATILLA COUNTY, OREGON

DATE **3-9-78**

SCALE: **1" = 40'**

● MONUMENTS FOUND

(000) OF RECORD

○IRON RODS SET **1/2"**

JOB NO. **S 7803064**

◎ HOLE IN CONC.

EDWARDS SURVEYING

567-3336

P. O. Box 763

Hermiston, Ore.

REGISTERED PROFESSIONAL LAND SURVEYOR

G. Dennis Edwards

OREGON
JULY 16, 1971
G. DENNIS EDWARDS
951