


LEGEND

- - FND 3/4" IRON PIPE
- - SET R.R. SPIKE
- ⊙ - FND 2" PIPE

20' UTILITIES EASEMENT

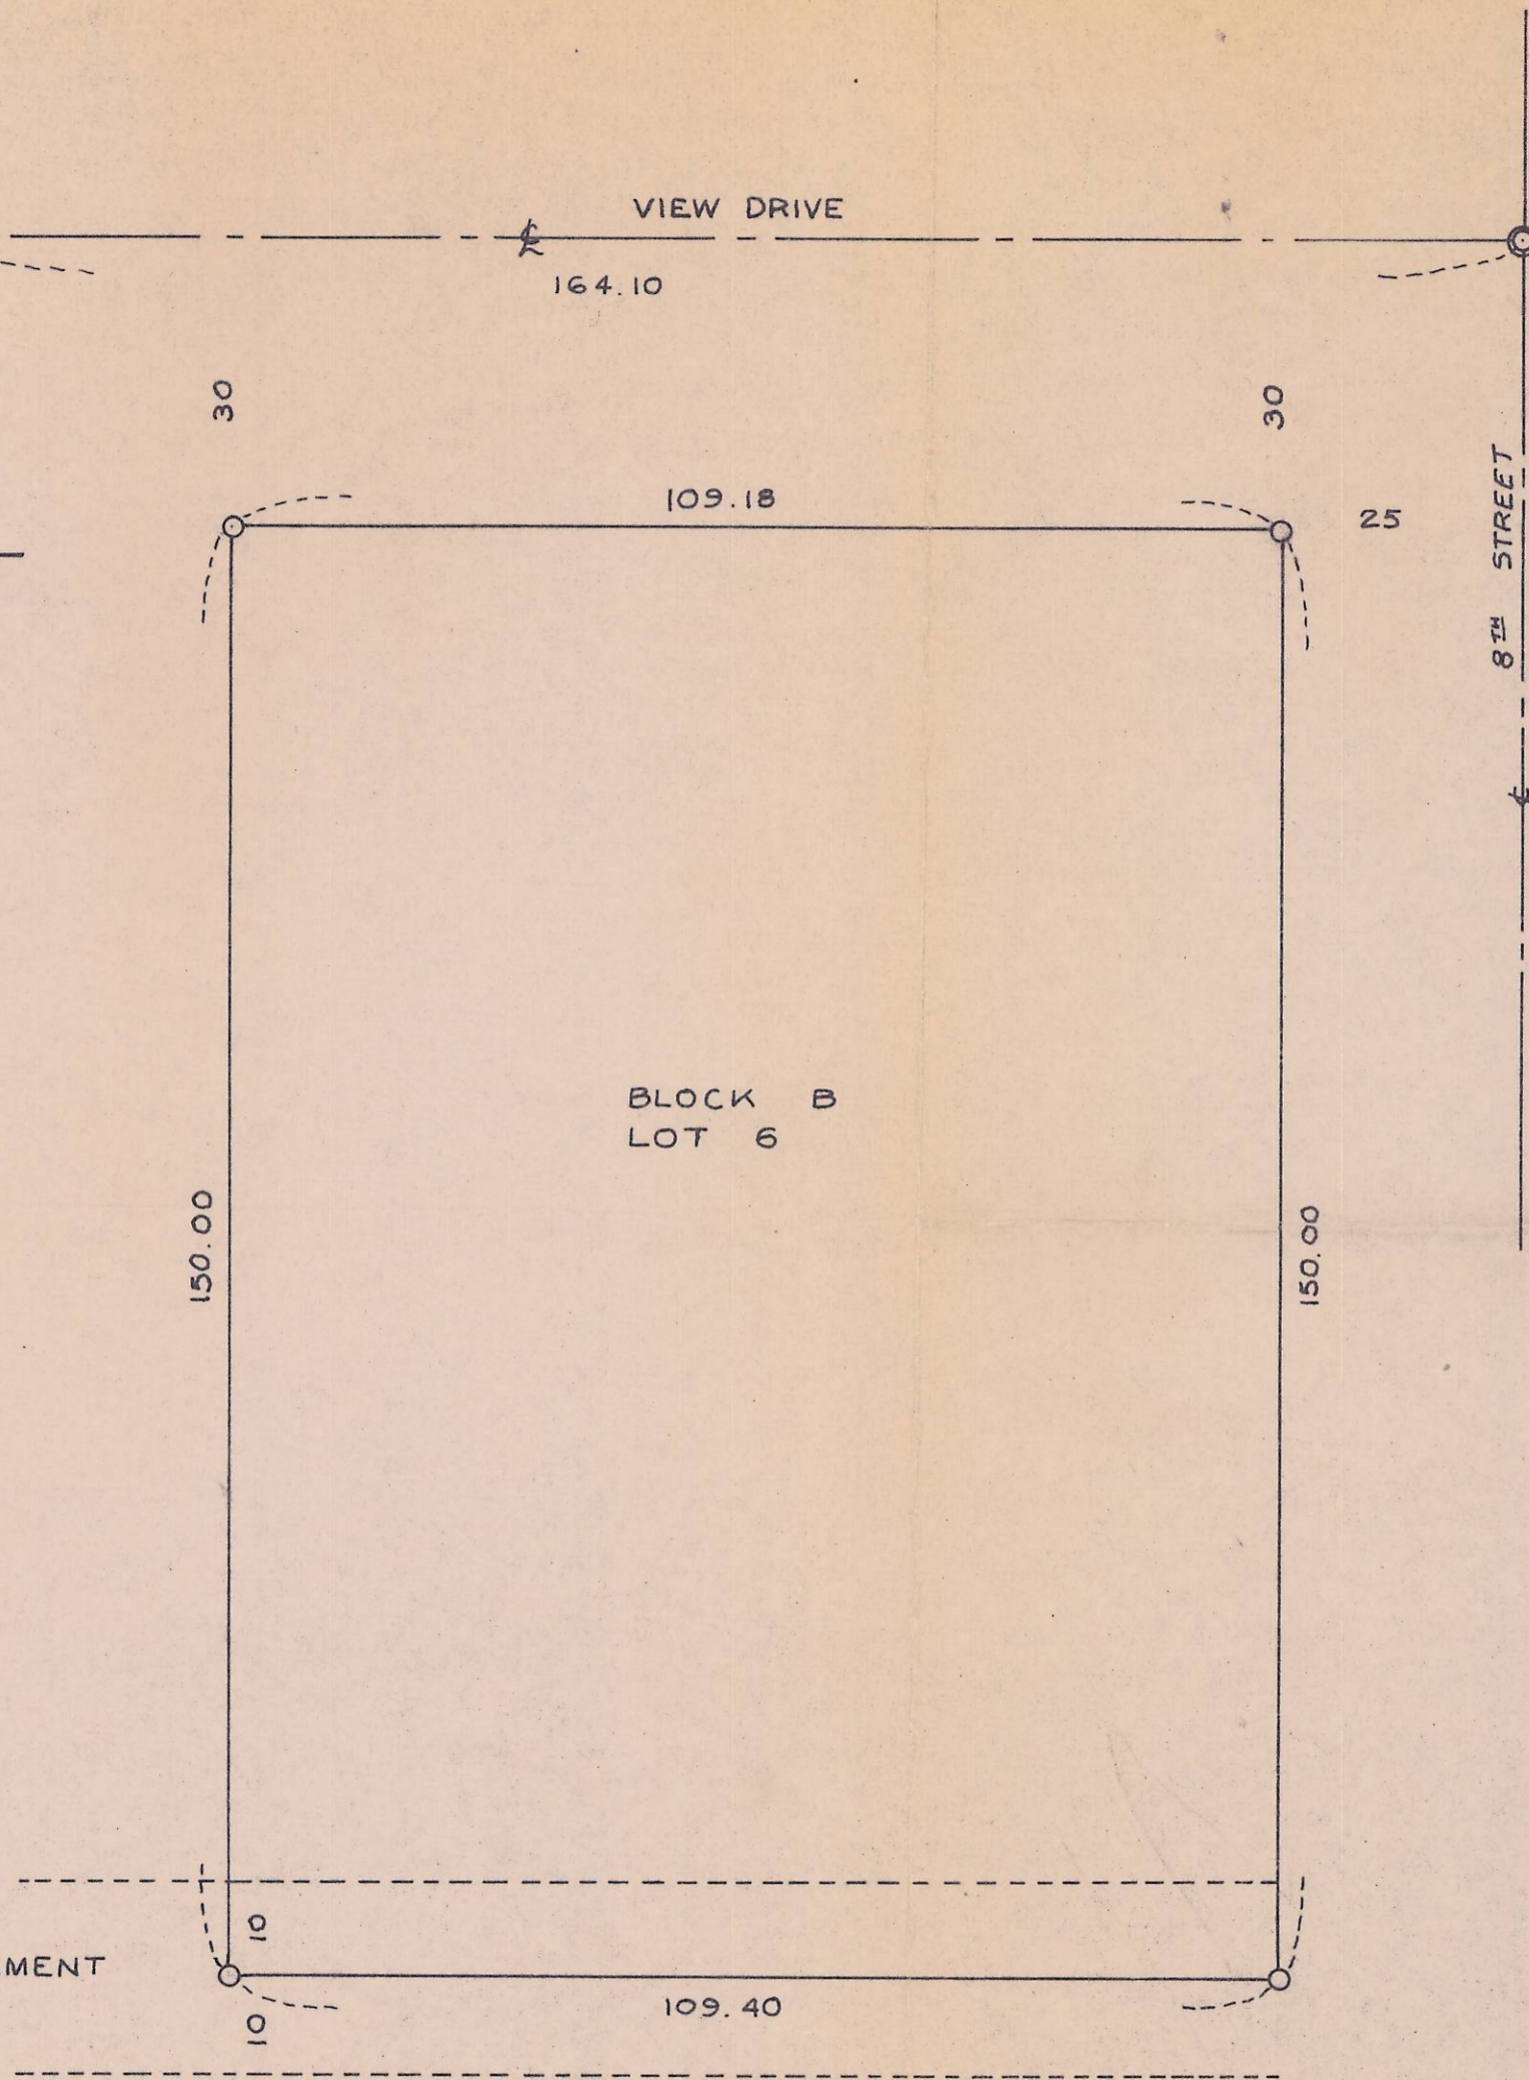

REGISTERED
PROFESSIONAL
LAND SURVEYOR

David H. Krumbein

OREGON
JULY 17, 1970
DAVID H. KRUMBEIN
933

Q-294-A

Q-294-A

SURVEY FOR		WAYNE HARRIS CO. INC.		
DUANE ALEXANDER		ENGINEERS - SURVEYORS PENDLETON, OR.		
SCALE	1"=20'	DRN. BY	D.W.B.	DRNG. NO.
DATE	7-7-75	CKD. BY	DNK	75-75B

4N 28 14AC