

STRANIX & OFNER
ENGINEERS

766

PENDLETON

OREGON

SURVEY FOR JESS CORREA

T.3N. R.29E SEC.5


DRAWN BY: C.J.M.

DATE: 7-28-49

SCALE: 1" = 40'

● 1 1/2" GIP

1/4 S
6 X 5

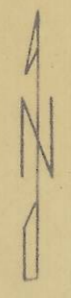

N. 1114.10

To SW Cor. S. 5

557.21
S. 76°-24' E.

OSHD R/W

S. 81°-45' W
275.80

0.32 ACRES

272.10
S. 76°-24' E.

103.80
N. 4°-44' E.

0219

Q-508-A

STRANIX AND OFNER
ENGINEERS
PENDLETON, OREGON

PHONE 492

29 July, 1949

Mr. Frank B. Hayes, County Engineer
Umatilla County
Pendleton, Oregon

Dear Sir:

The following is an abstract of the field notes of a survey made for Mr. Jess Correa, Jr., in section 5, T.3N., R.29E., W.M.

Located the $\frac{1}{4}$ Cor between Sections 5 and 6 as a large oak tree approximately three feet in diameter. Mr. Correa Sr. stated that many years ago an iron pin was immediately next to this tree and on the east side thereof. The pin is now approximately six inches from the east side of the tree now due to growth of the tree in the intervening years. Location of the tree was pointed out by Mr. Correa, Jr.

The section corner common to sections 5, 6, 7 & 8 was established as a fence post set by Mr. Correa Sr. at the section corner marked at that time by an iron pin which has since been obliterated by the construction of an irrigation ditch. Location was pointed out by Mr. Correa, Sr.

Section line between $\frac{1}{4}$ cor and sec cor described above was further established by a row of old trees which Mr. Correa Sr pointed to and stated that the trees had been planted on the section line.


Northerly right-of-way of US Highway 30 was established by State of Oregon Highway Dept. right-of-way iron pins located east and west of the property to be surveyed and intervisible.

The point of intersection of Highway right-of-way and section line was established by intersecting these two lines.

The survey was then accomplished according to the accompanying map.

Very truly yours,
STRANIX AND OFNER, ENGINEERS

cc: J. Correa, Jr.
Oregon Title Ins. Co.

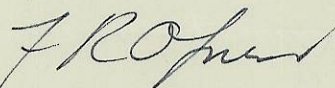
F. R. Ofner

Q-508-A

T 3N R 29 E S 5