

Q-534-A

Preston Stone Mon. Street

60' 100'

Street

434.0

Main

622.9

3970 ±

Stone Mon. + Stone →

348.0

90°


144'

4.4 Acres.

Creek

Wild Horse

Tract of Land Surveyed for Wm Baker - Adams Ore. Oct 12 1915. Scale 1" = 100' Willard Bradley County Surveyor. Sec. 4+9 T3N. R34 E.W.M

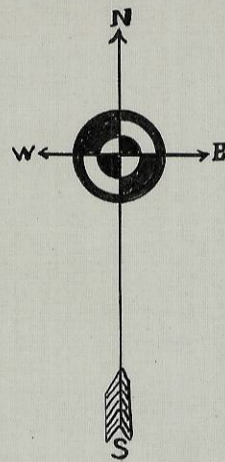

Sec. line between Sec's 4+9 T3 N; R34 E.W.M.

Q-534-A