15A

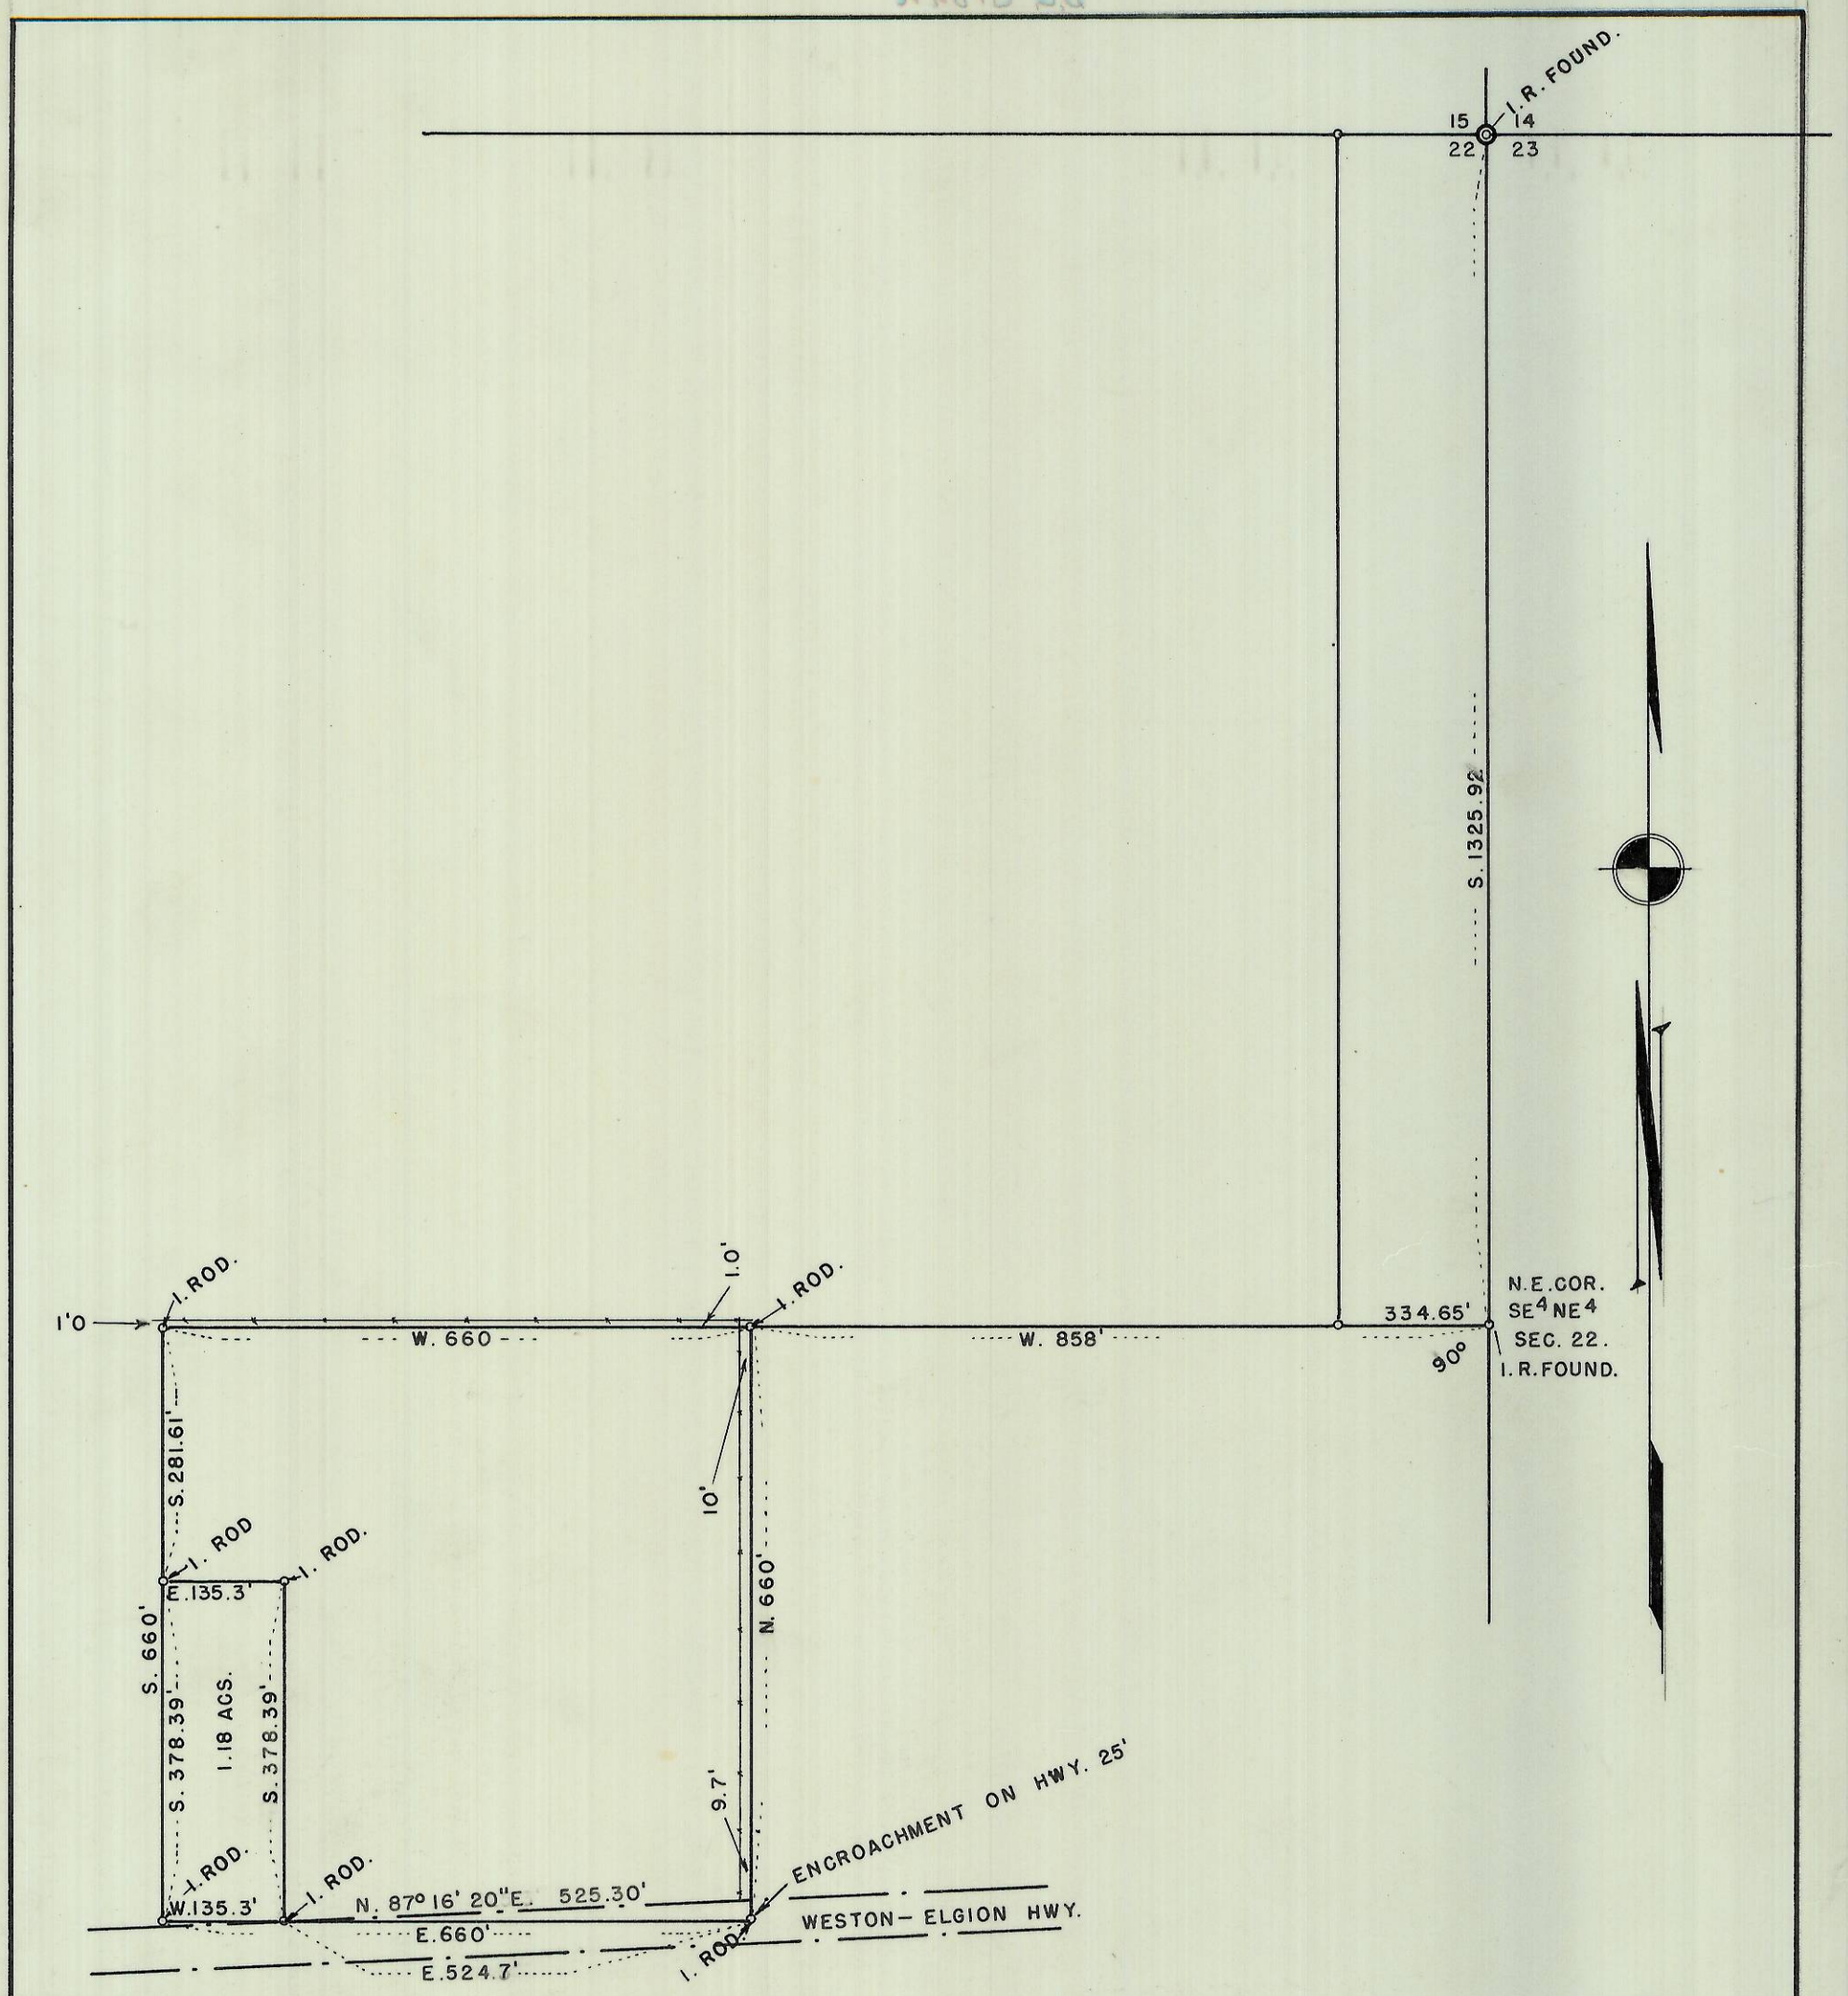

REGISTERED PROFESSIONAL ENGINEER
197
OREGON
DEC. 8, 1919
F. B. HAYES

Q-740-A

HAYES & HARRIS ENGINEERING

SURVEY FOR

D. C. SLOAN

A PARCEL OF GROUND LOCATED IN SE4 NE4 OF SEC. 22, T. 4 N., R. 35 E.W.M.

SCALE	DATE	DRAWN BY
1"= 200'	9/25/55	F. B. H.

Q-740-A

15A