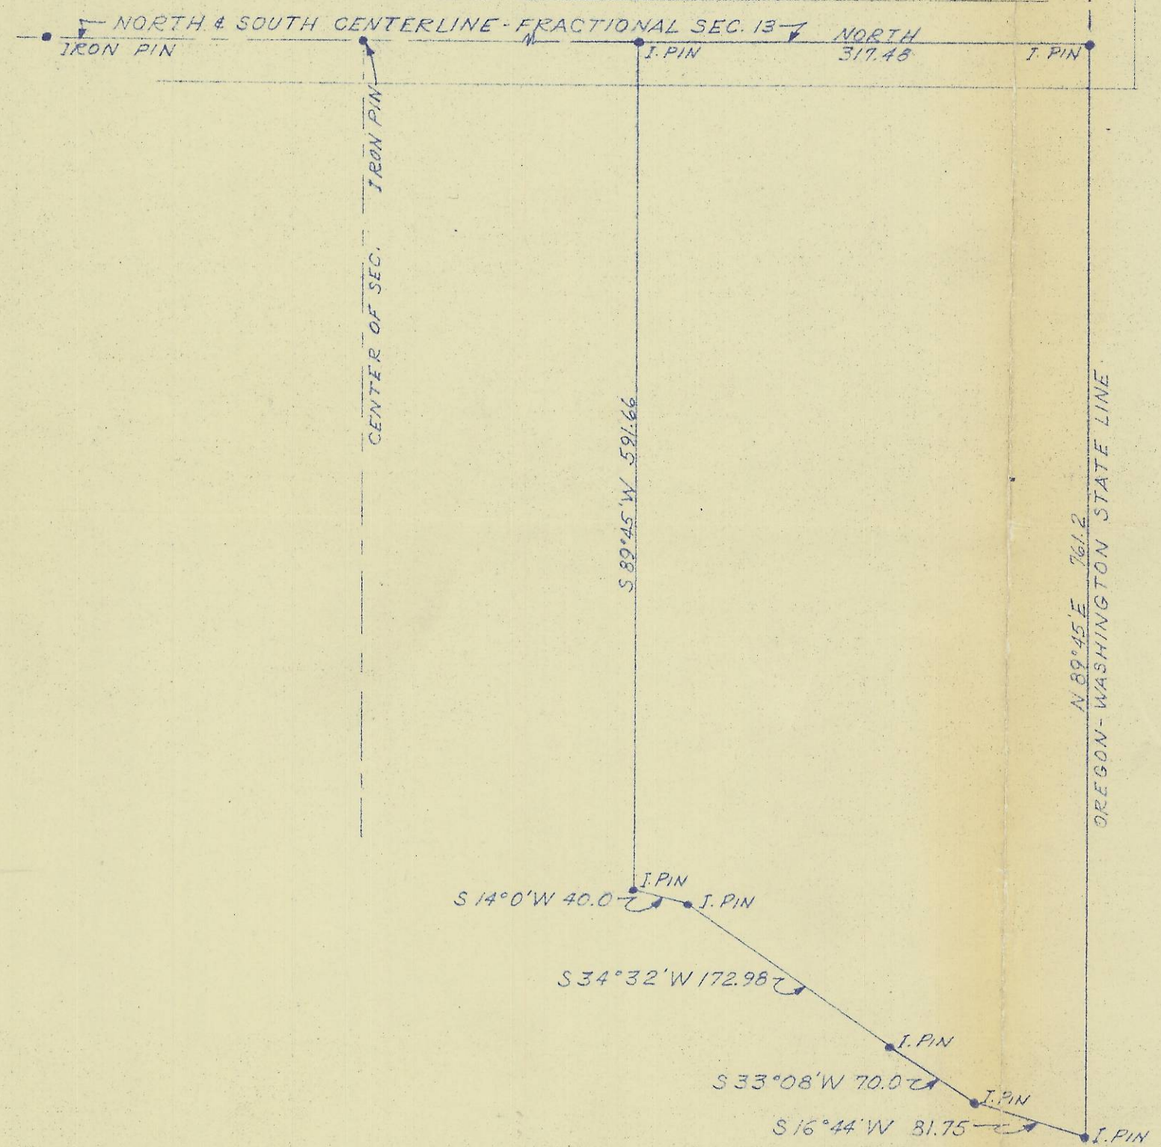

SCALE 1" = 100'

G. M. NEWBILL

LICENSED LAND SURVEYOR

17 N. Second — Walla Walla, Wash. — Phone 4170

Surveys
Descriptions
Sub Divisions

A SURVEY
FOR
McDONALD AGENCY
SECTION 13, TWP. 6 N, R 35 EWM.

Date 5-2-56
Drawn By DTD
Checked By GMN

No. 1786