
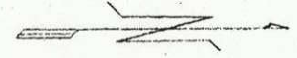


ROCK
SW. CORNER
SEC. 25-6-35

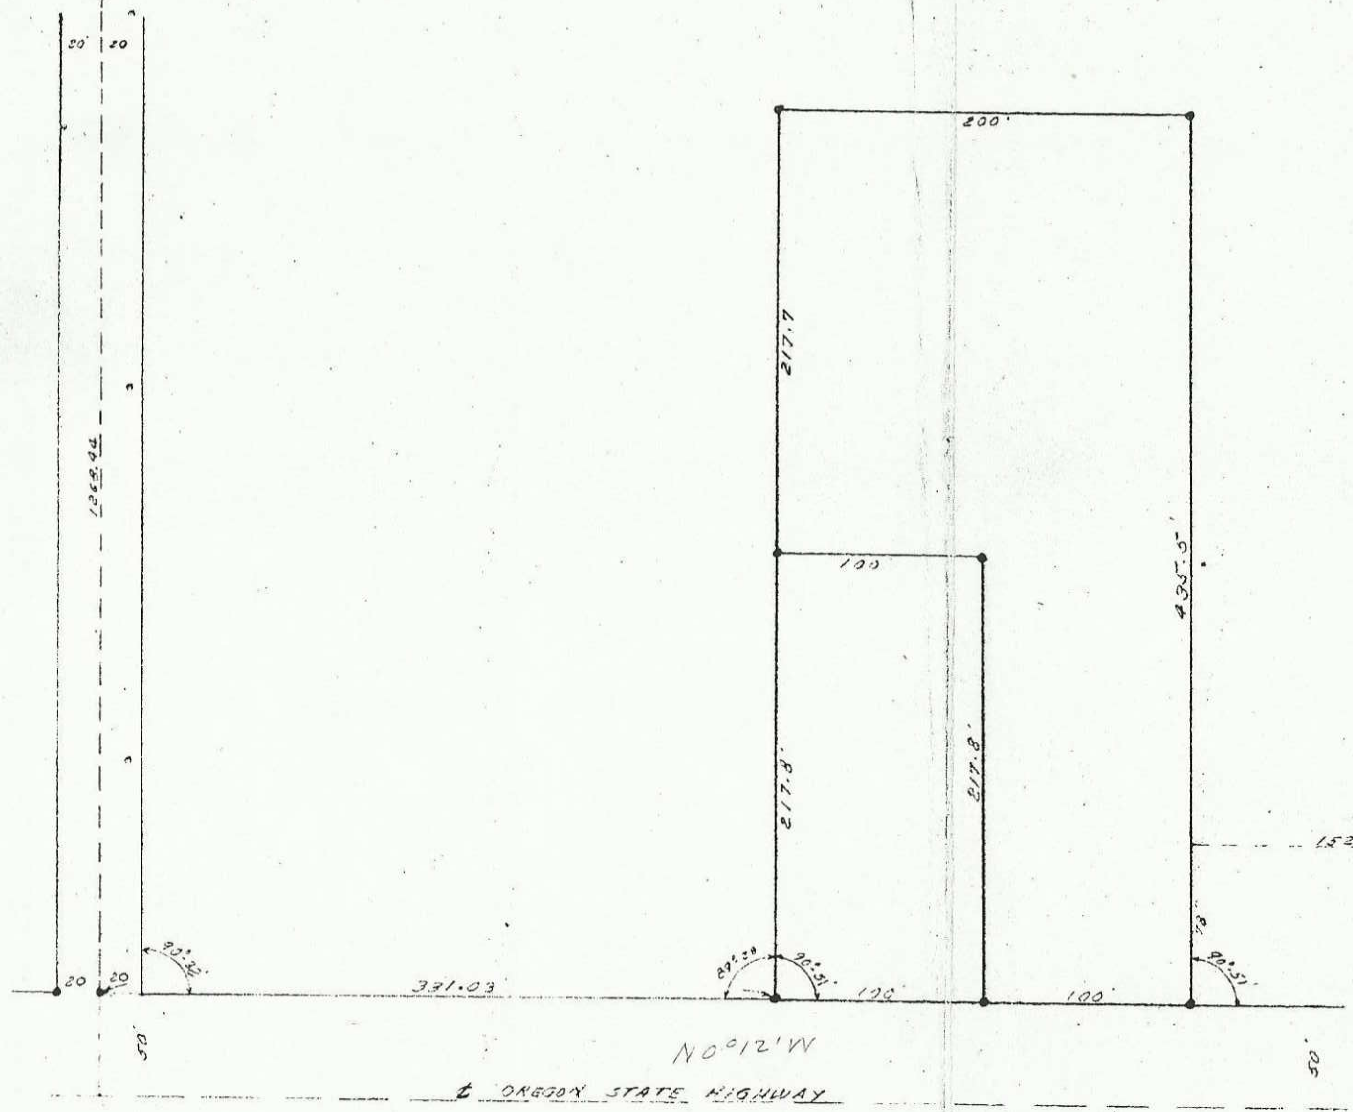

SCALE 1" = 60'

● DENOTES IRON PINS

OPTION
BY G. M. NEWBILL
G. M. NEWBILL
255

Q-833-A

G. M. NEWBILL	
LICENSED LAND SURVEYOR	
17 N. Second	Walla Walla, Wash. Phone 417
Surveys	A SURVEY
Descriptions	FOR
Sub Divisions	FERGUSON & WILLIAMS
	SECTION 25-6-N-R 35-E
Date	3/2/57
Drawn By	G.M.N.
Checked By	No. 1917