
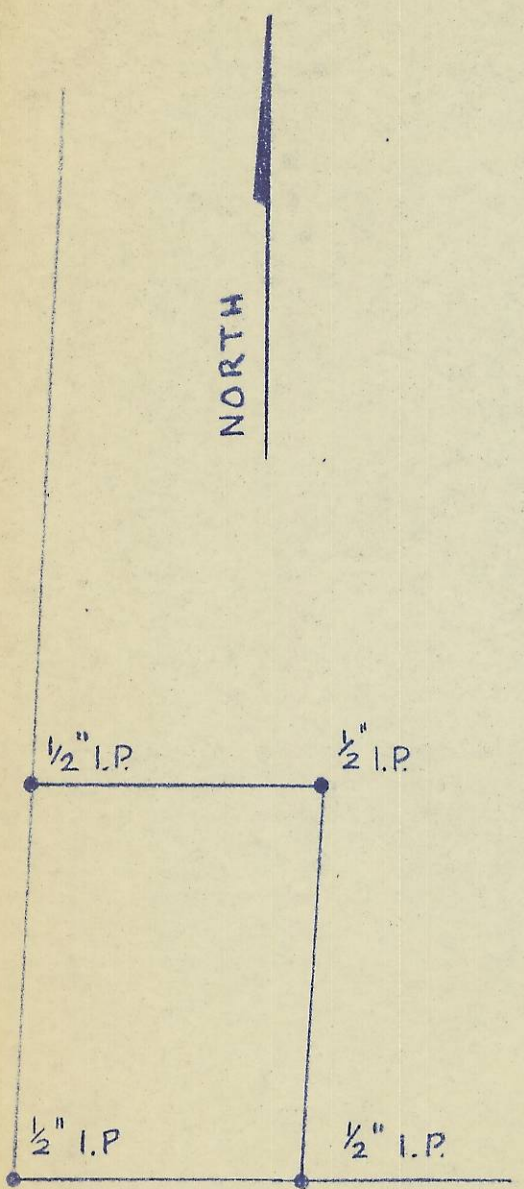



35 36
2 1 FENCE CORNER

5 N 35 - 1 NW NW

NE 8th & Co.
NE (2)

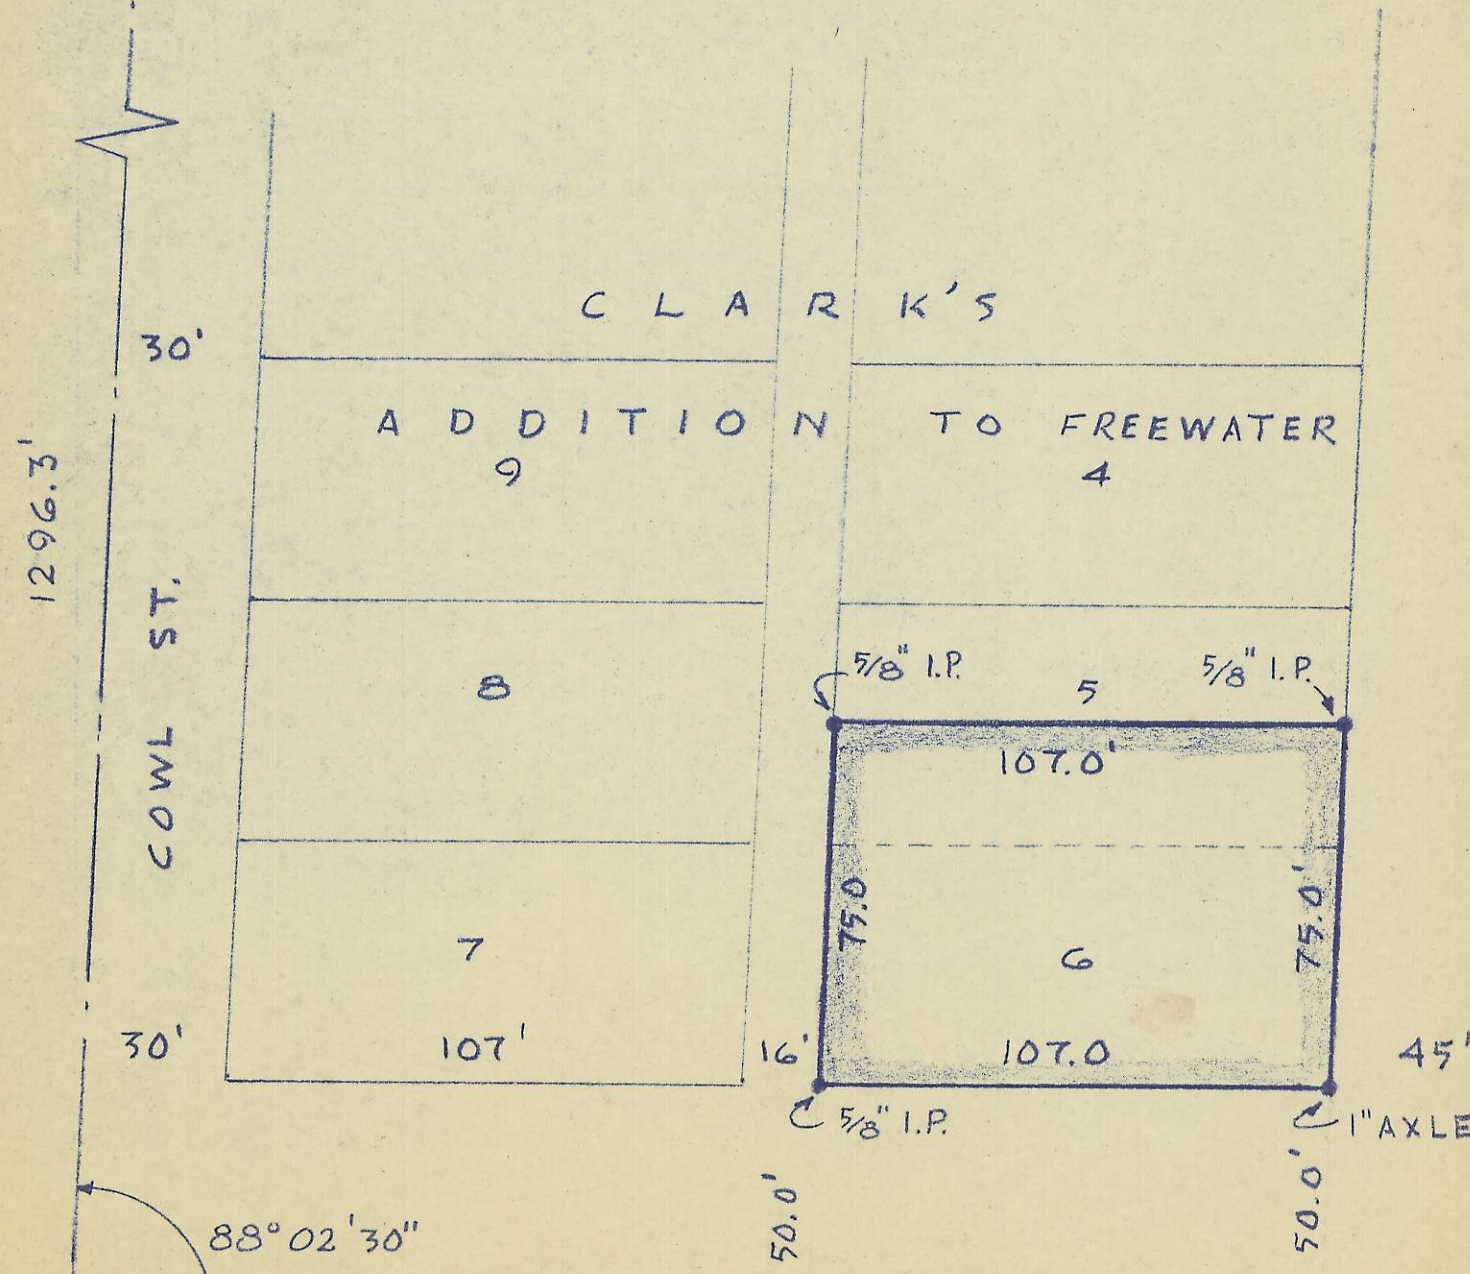

A PROPERTY SURVEY
OF LOTS 5 & 6 BLOCK 1
CLARK'S ADD. TO FREEWATER
FOR GEORGE B. JOHNSON
MILTON-FREEWATER, OREGON
SCALE: 1" = 40'-0" DATE: SEPT. 59

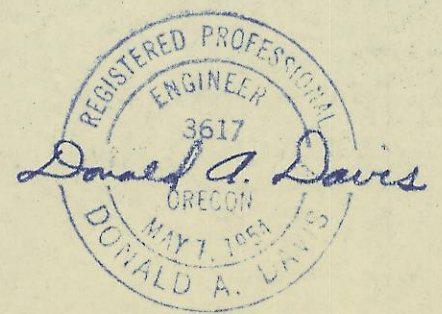

ELIZABETH ST.

I.P. 88° 02' 30"
S.W. CORNER
N.W. 1/4, N.W. 1/4
SECTION 1, T5N, R35E.

Q-997-A