


NORTH

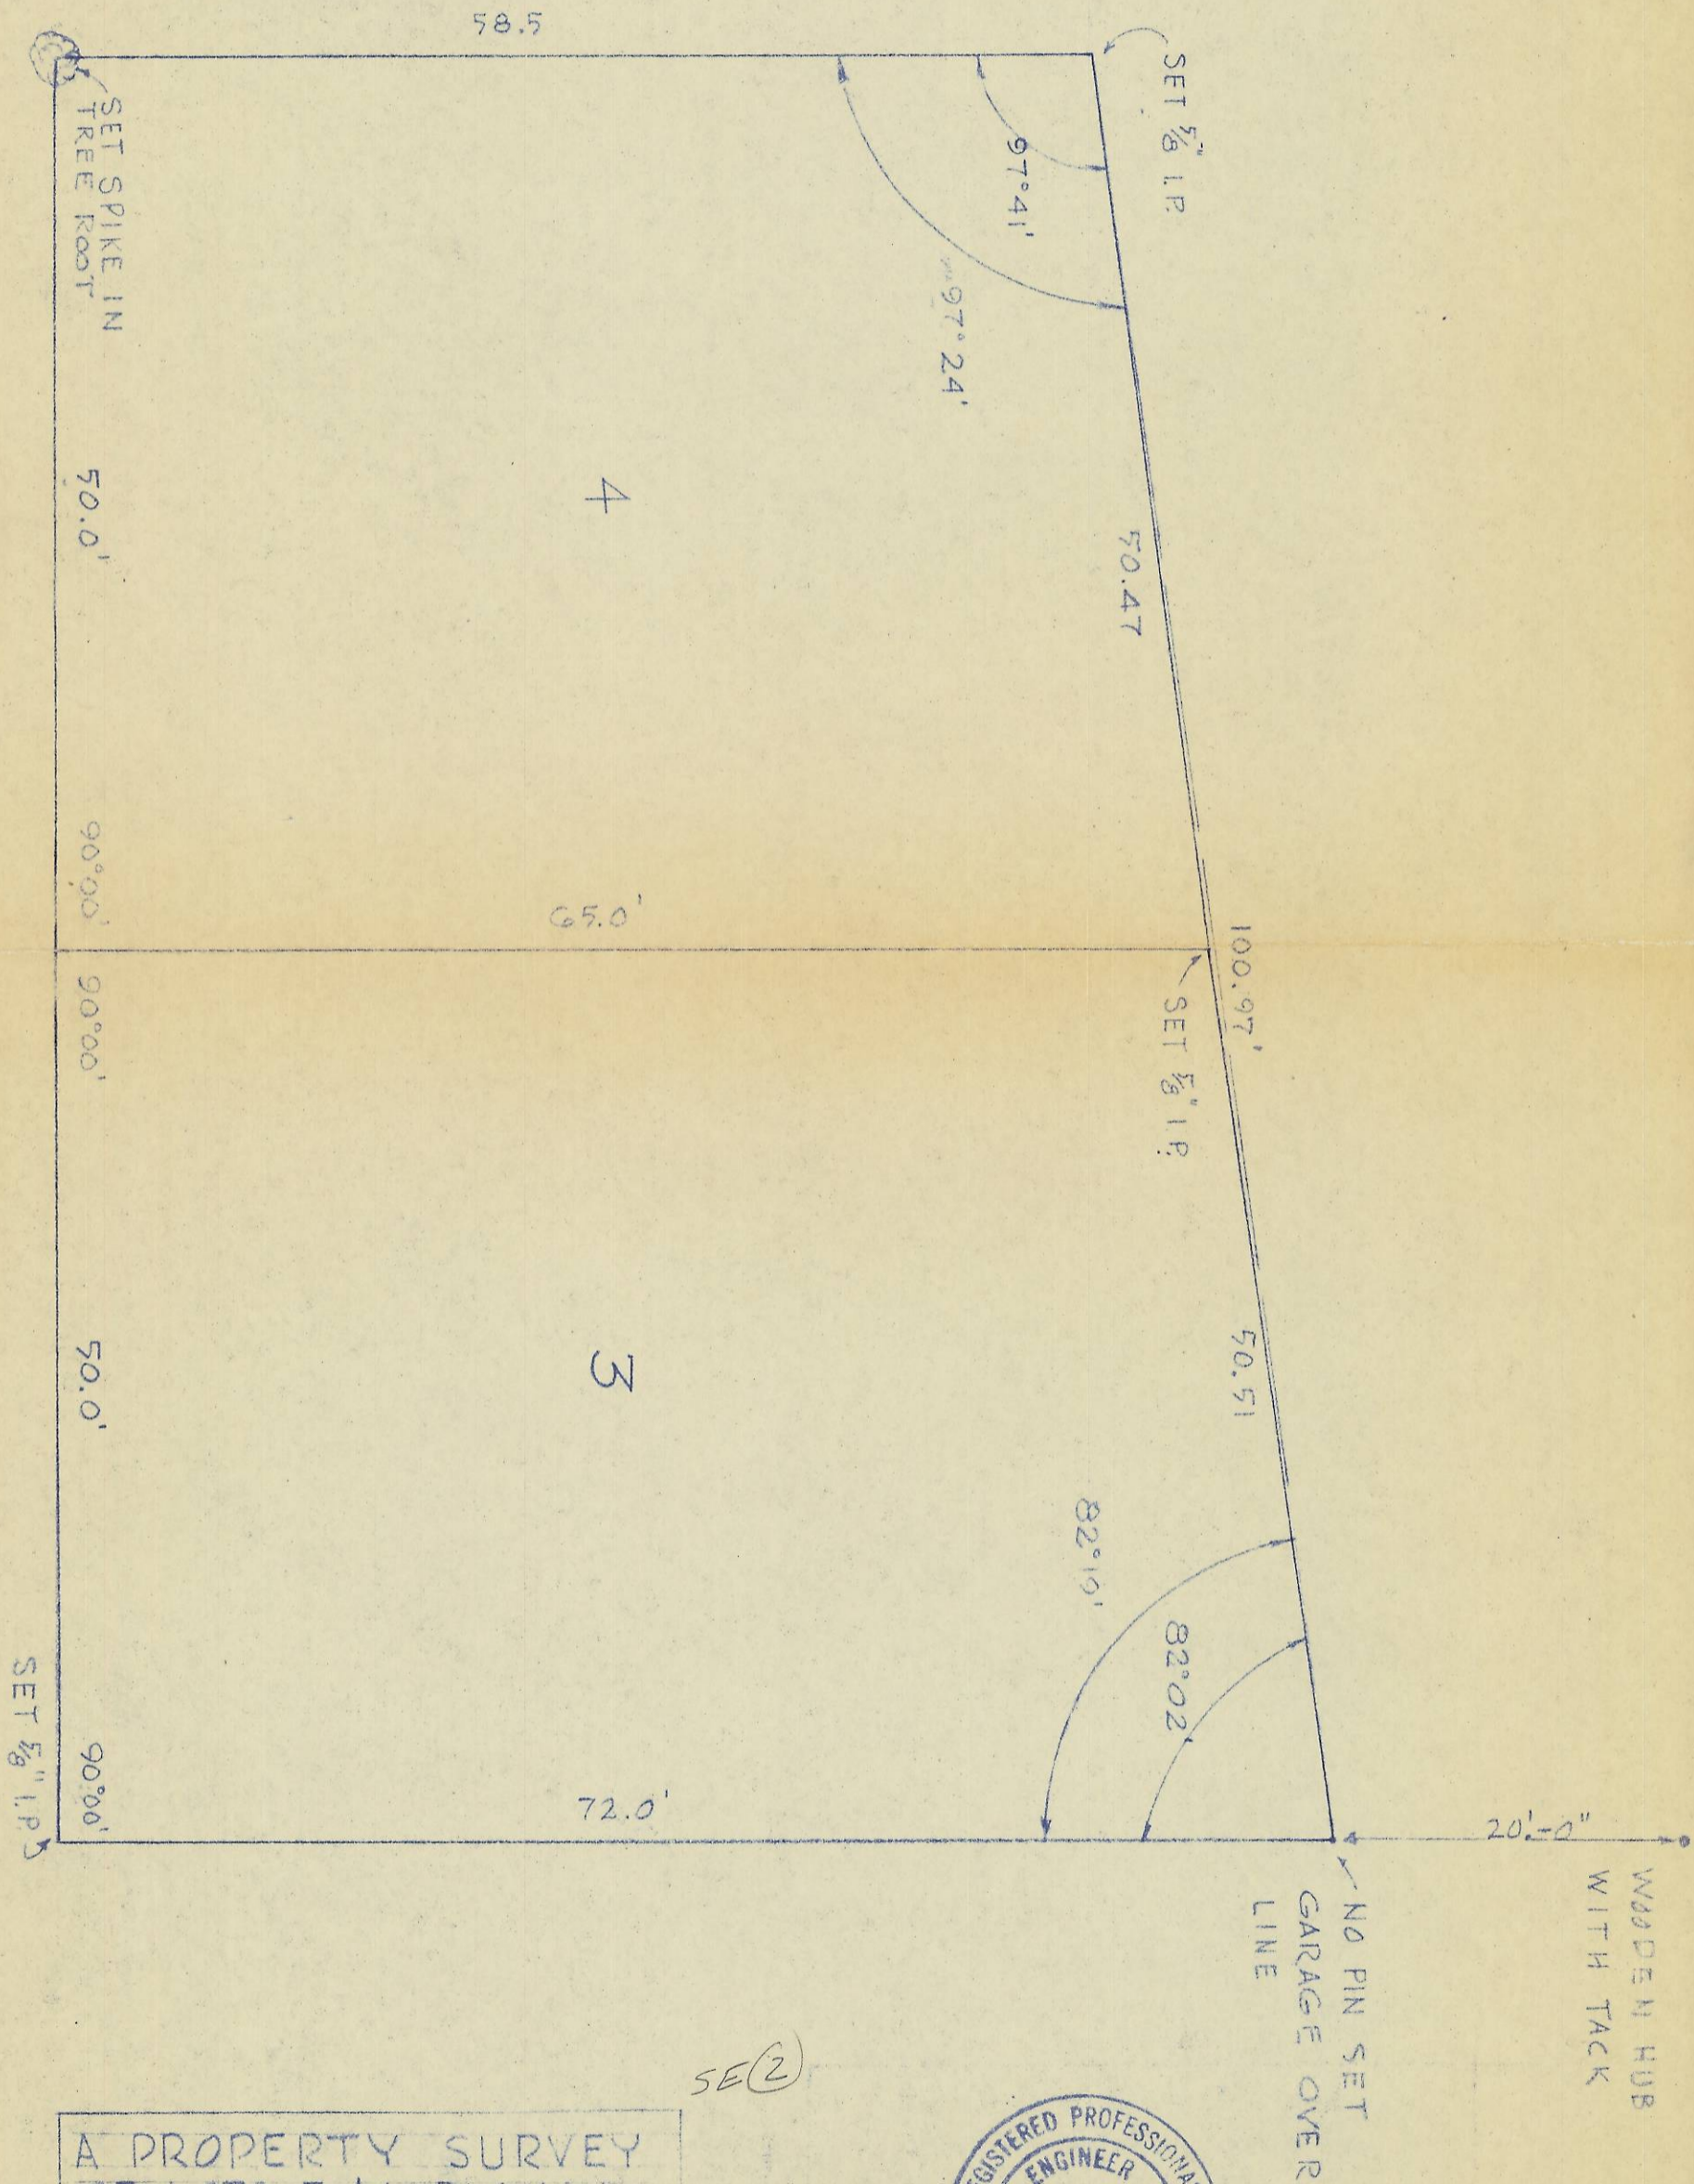

A PROPERTY SURVEY  
 OF LOTS 3 & 4, BLOCK 1  
 NORTH MILTON ADD.  
 FOR ELTON E. FENNO  
 MILTON-FREEWATER, OREGON  
 SCALE: 1" = 10'-0" DATE: AUG. '59



SE(2)

5N352DB