


Q-1051-A

OSCAR SCHULTZ TRACTS

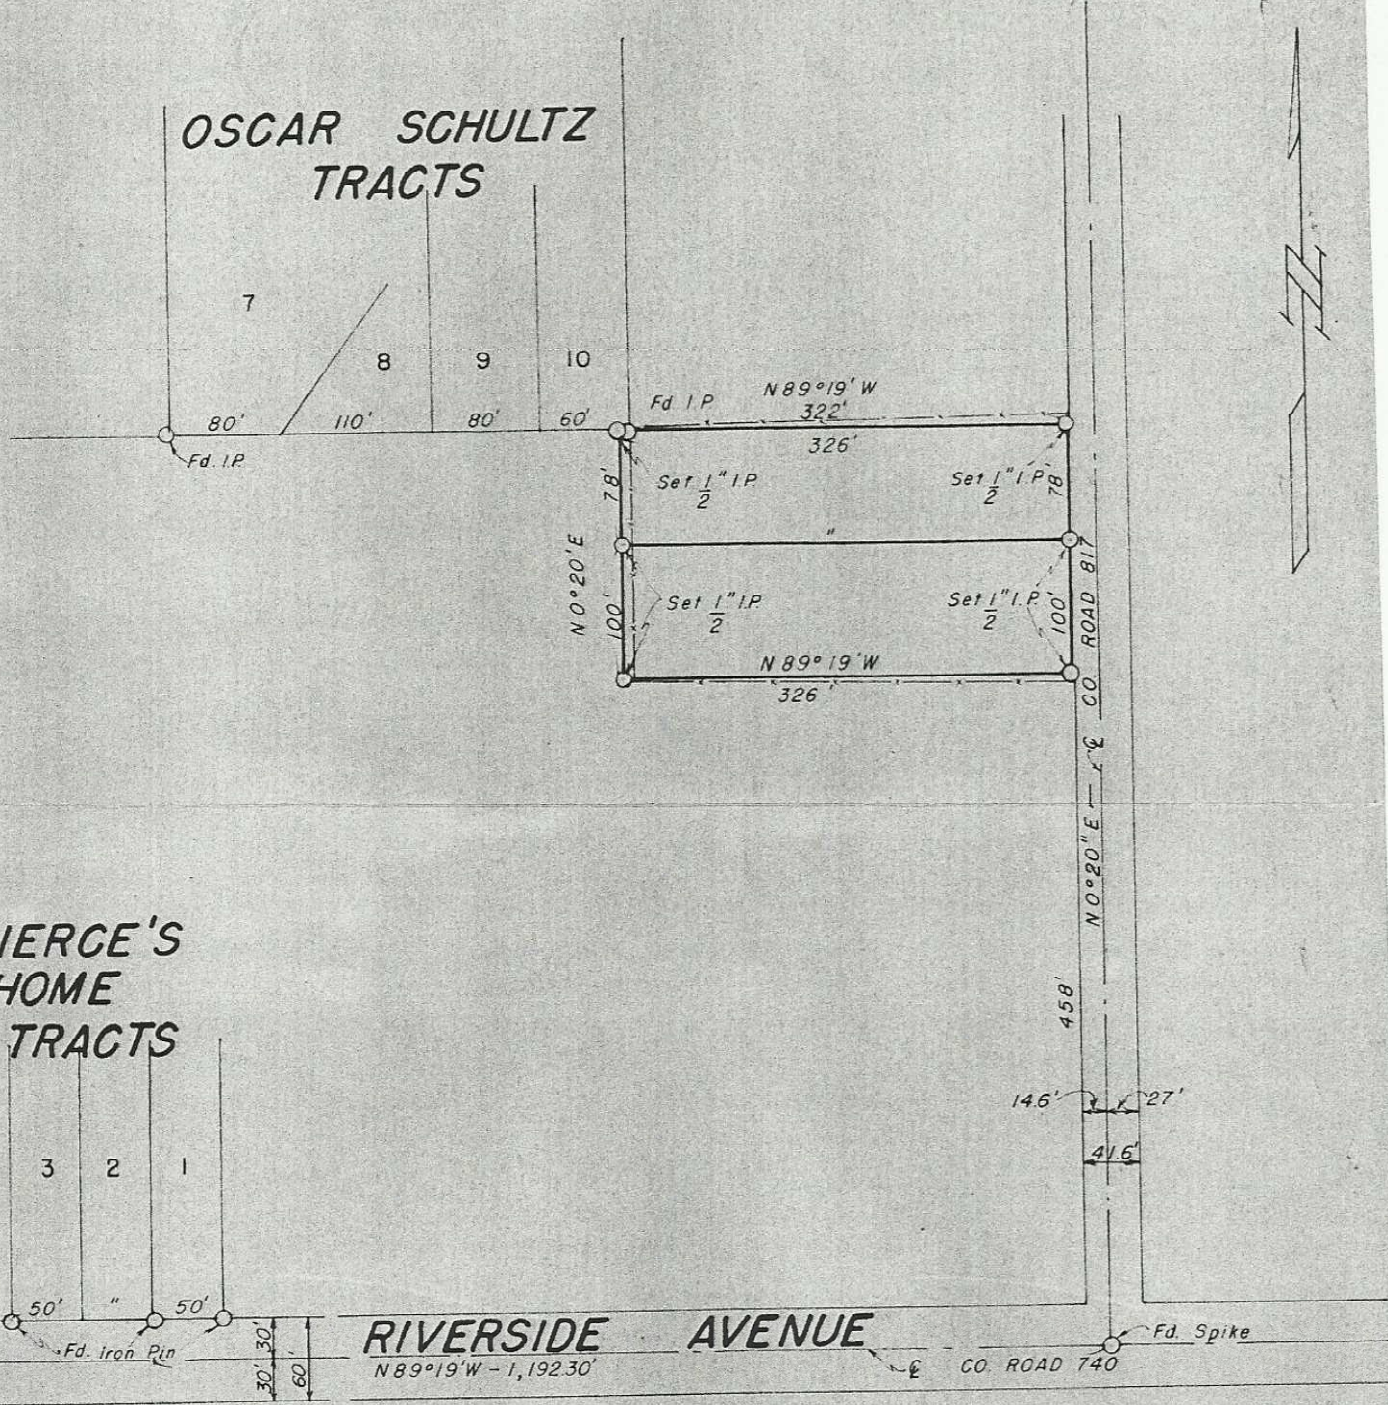

PIERCE'S HOME TRACTS

SURVEY FOR

FLOYD HOLADY

PART OF SE⁴ SE⁴ SEC. 1 - T2 N-R32 E-W.M.

Date: 5-19-56

Scale: 1" = 100'



Original (286)