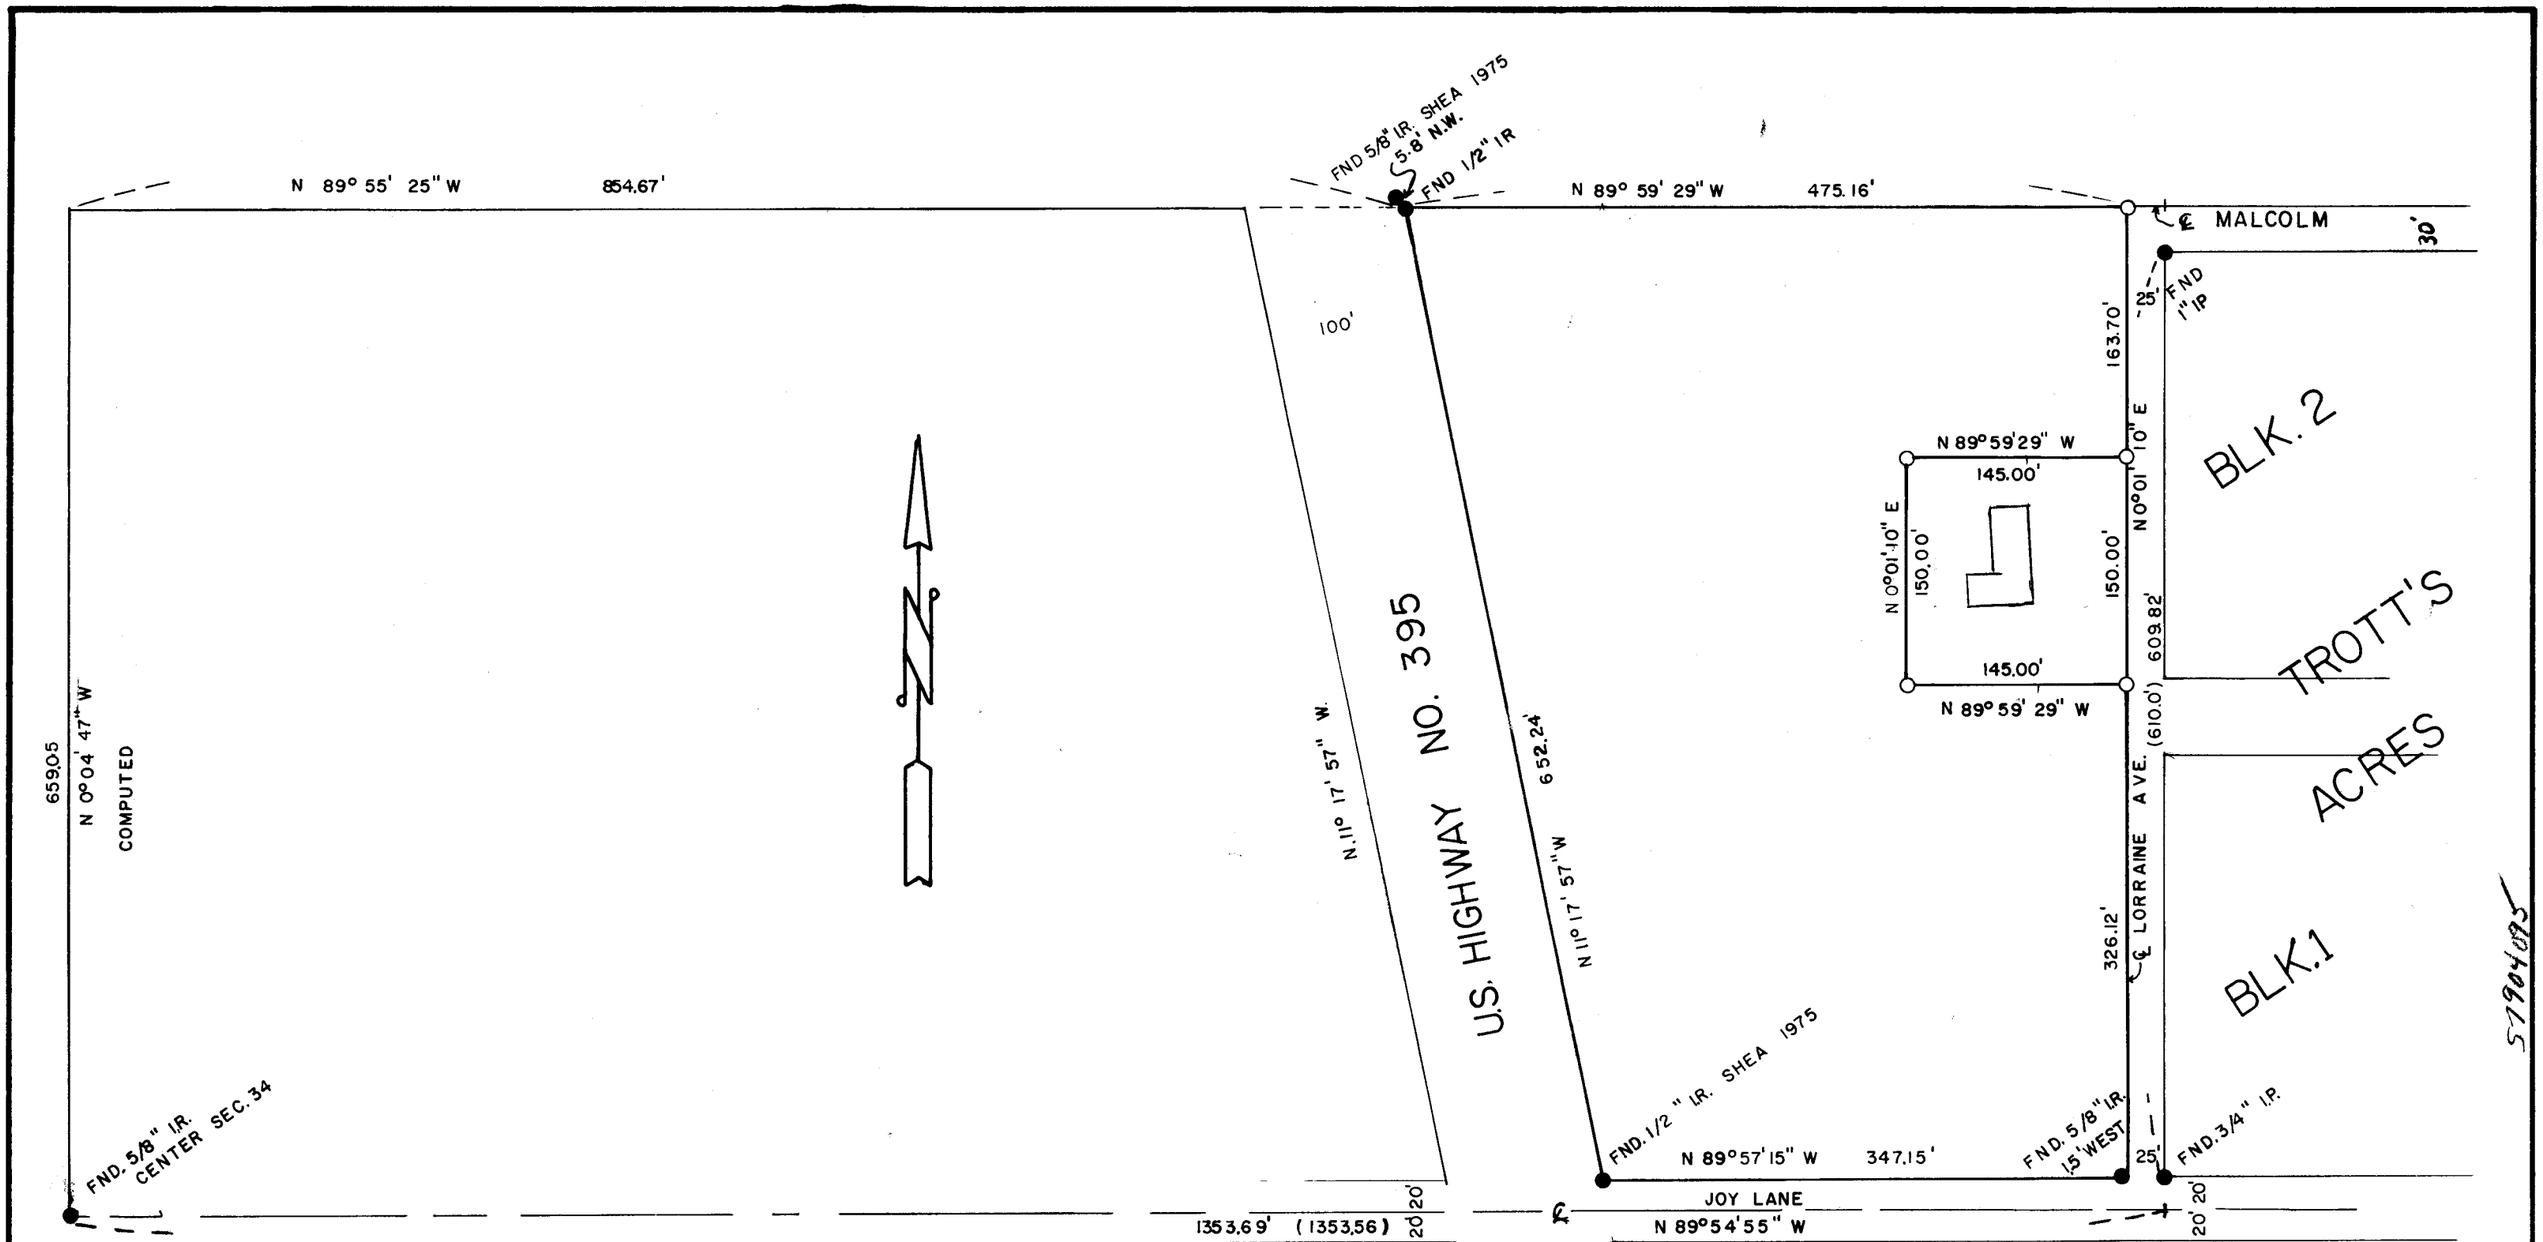

SURVEY FOR: ROSMA & BAKER

LOCATION: N.E. 1/4 SEC. 34 T5N, R.28.E,W.M.,

UMATILLA COUNTY, OREGON

DATE 4-23-79 SCALE 1" = 100'

● MONUMENTS FOUND (000) OF RECORD

O 1/2" IRON RODS SET JOB NO. S7904095

EDWARDS SURVEYING P.O. Box 763

567-3336 Hermiston, Ore.

REGISTERED PROFESSIONAL LAND SURVEYOR

G. Dennis Edwards

OREGON JULY 15, 1971 G. DENNIS EDWARDS 951

Q-1083-A