

Y 2002 0009 4411000



S.W. Cor. Lot 24
Block 8

S 0° 53' W
182.70'

N 89° 01' W
685.05'

S.W. Cor. Lot 13
Block 9

62° 16'

S 26° 53' E
195.65'

776.36'
E

Set iron Pin



20°

99.60'

Set iron Pin

81.10' to E.R.R.

UMACO ROAD DEPT.
T5N R28EWM SCALE 1" = 50'
UMATILLA PROP. SURVEY
DRAWN BY SCHAEFER
2/21/55

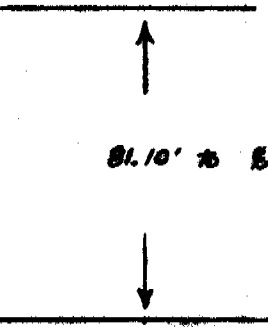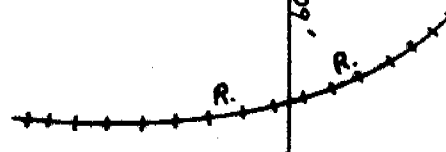

756

Q-1345-A

Q-1345-A