


4 3
9 10

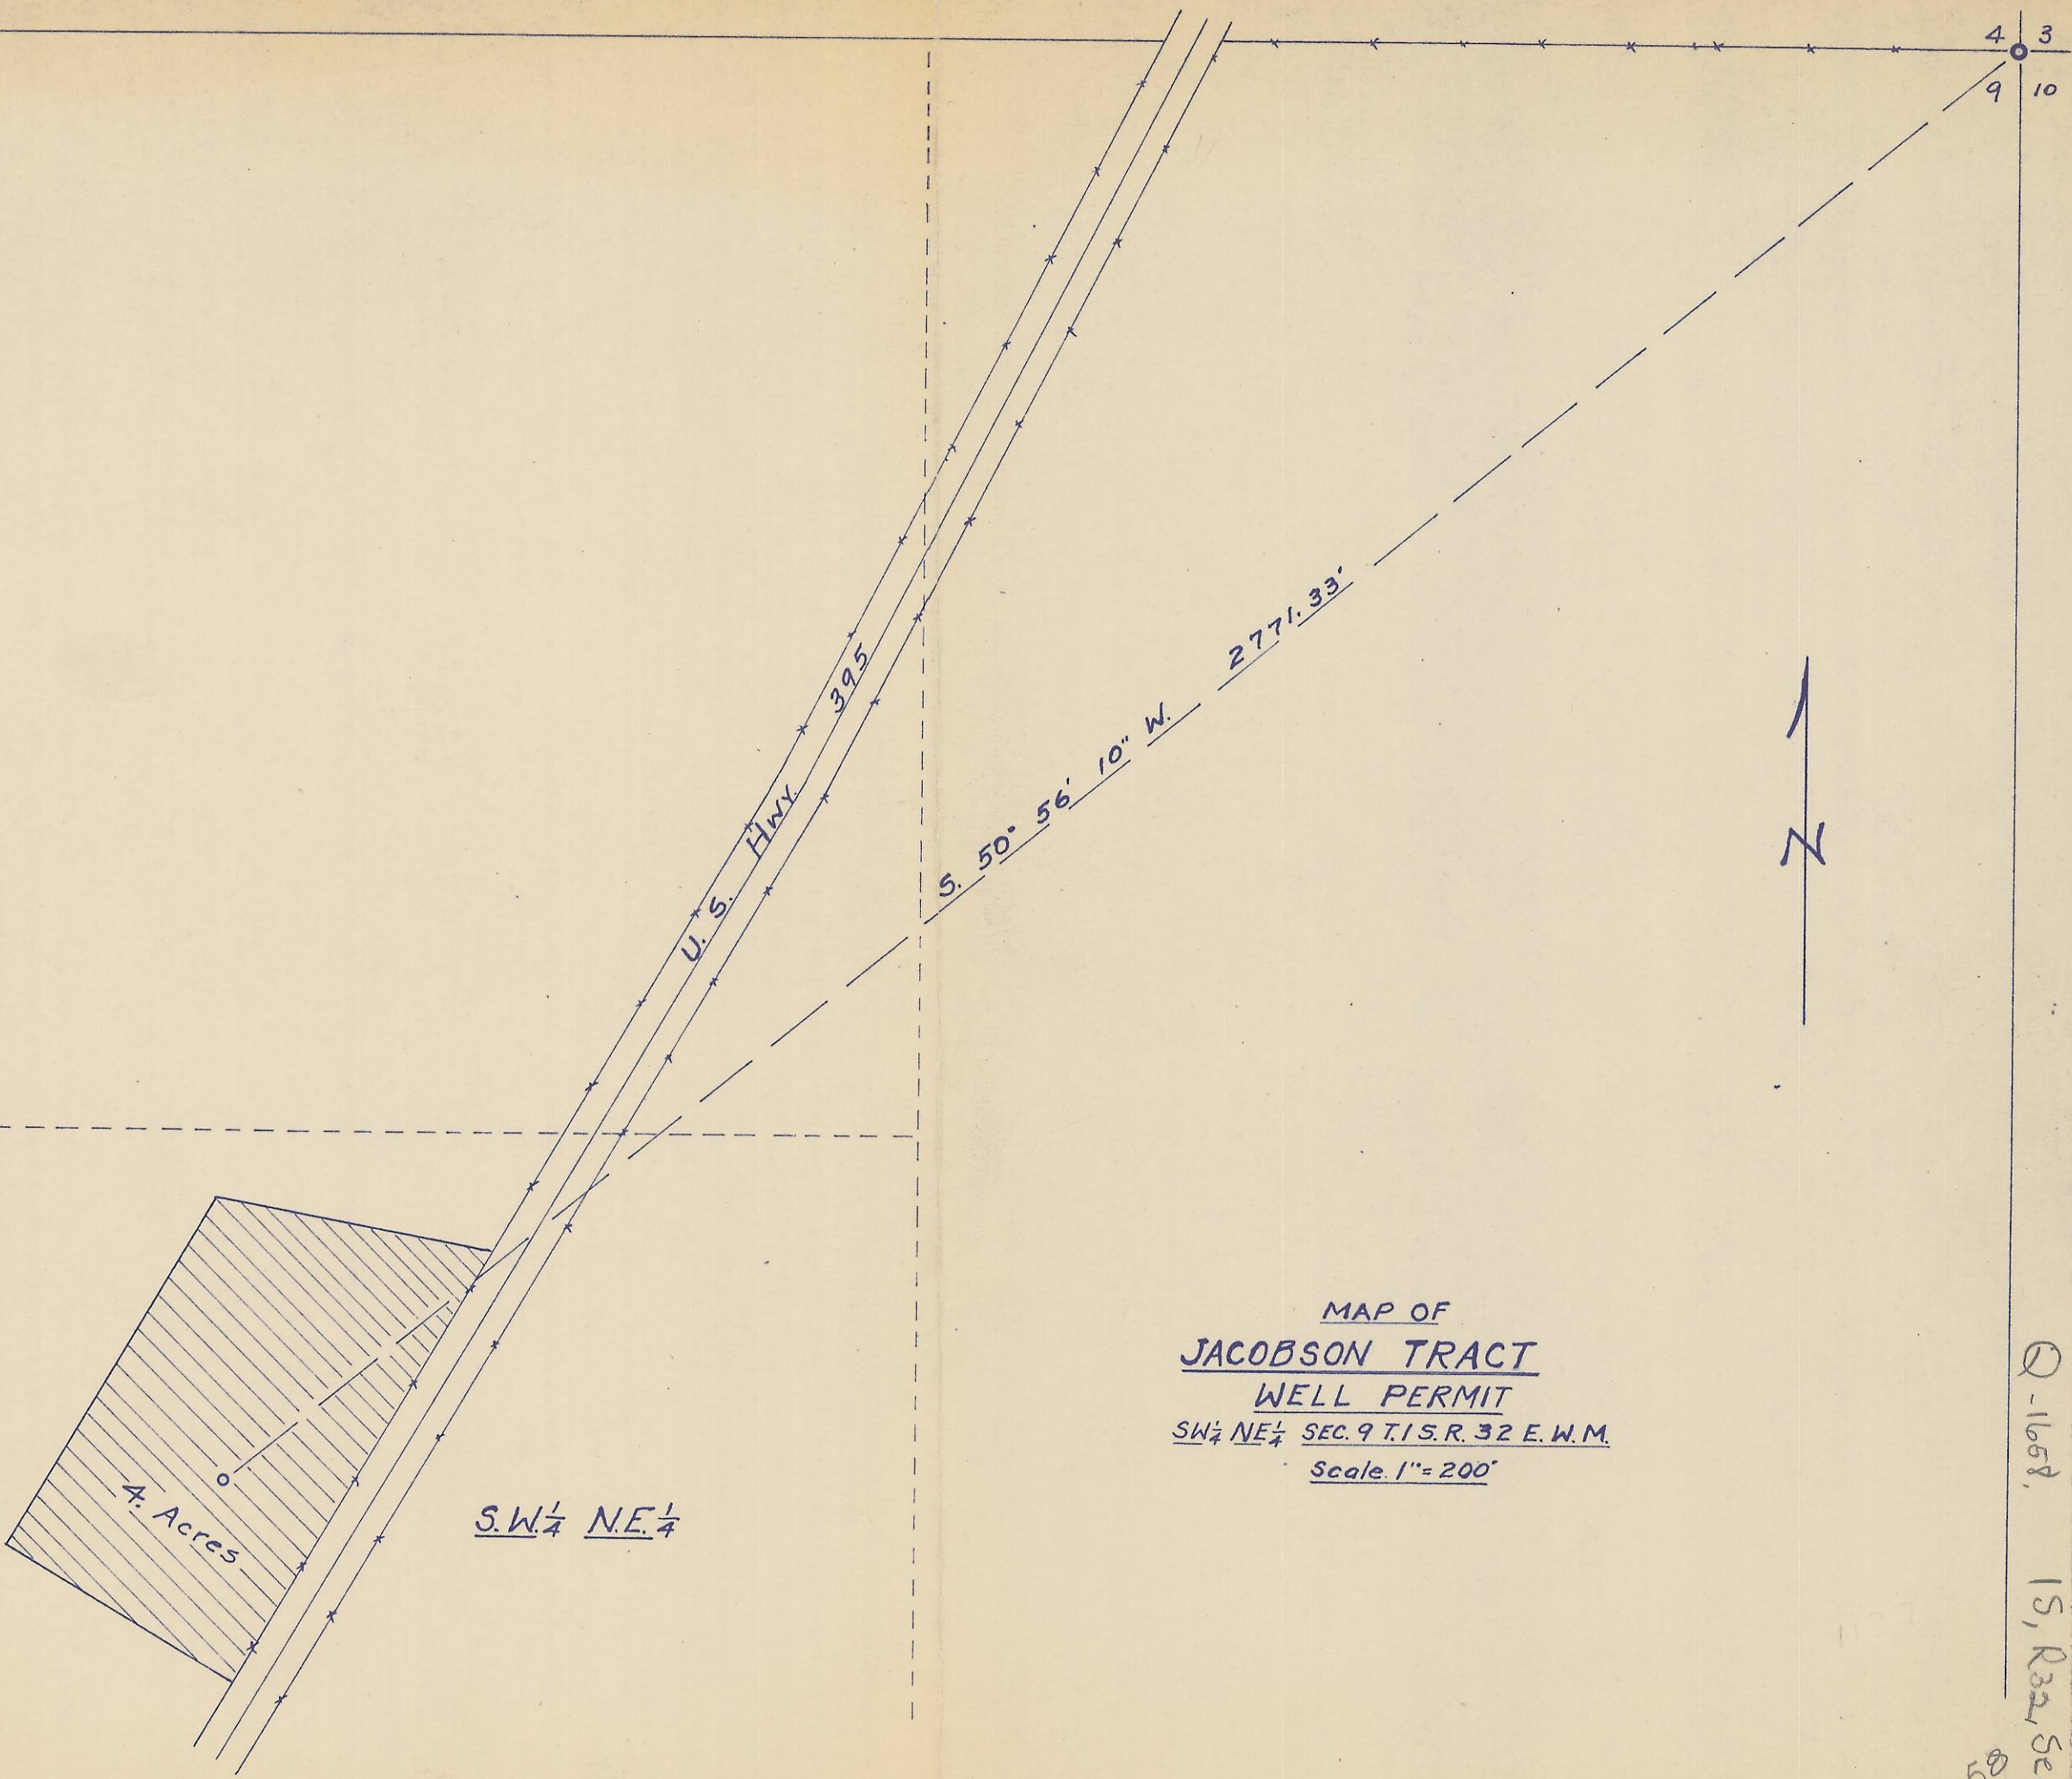

MAP OF
JACOBSON TRACT
 WELL PERMIT
 SW $\frac{1}{4}$ NE $\frac{1}{4}$ SEC. 9 T. 1 S. R. 32 E. W. M.
 Scale 1" = 200'

Q-1658, 15, R32, Sec. 9
 Q-1658