


N.W. COR., S. 1/2, S.E. 1/4,
N.E. 1/4, SEC 20

N 89°48'52" E 1323.34'

1159.48'

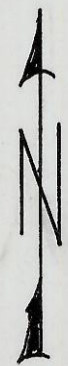

346.80'
366.80'

N 0°59'02" W 658.49'

311.69'
291.69'
20' EASEMENT

S.W. COR., S.E. 1/4,
N.E. 1/4, SEC. 20
FD. 1/2" I.R. 8.33' EAST
1978 EDWARDS SURVEY

FD. 5/8" I.R.
SEE 1979 EDWARDS
SURVEY FOR ECHOLS

FD. 1/2" I.R.
SEE 1979 EDWARDS
SURVEY FOR ECHOLS

REGISTERED
PROFESSIONAL
LAND SURVEYOR

G. Dennis Edwards

OREGON
JULY 16, 1971
G. DENNIS EDWARDS
951

NARRATIVE:

IN 1971 RALPH THOMPSON SET THE S.E. CORNER OF SECTION 20 IN A SURVEY FOR C&B LIVESTOCK CO. MANY SURVEYS WERE DONE USING THE BRASS CAP WHICH HE SET. SOMETIME IN THE LAST THREE YEARS THAT BRASS CAP WAS REMOVED. IN JUNE 1979 WALT CRAMER REESTABLISHED THE SAME CORNER 23.60 FEET TO THE WEST OF WHERE THOMPSON'S CORNER WAS LOCATED. THIS SURVEY IS BASED ON THE BREAKDOWN OF THE SECTION BY DONALD STAEBLER IN 1972 AND A SURVEY BY MYSELF IN 1978 FOR ECHOLS ET. AL., AND IS ADJUSTED TO FIT THE NEW SECTION CORNER WHICH CRAMER SET.

MAXWELL CANAL

N 67°59'33" E
460.09'

(A)

(B)

(C)

(D)

(E)

N 0°59'02" W 455.50'

N 01°02'26" W 547.18'

N 01°02'26" W 609.84'

N 01°02'26" W 630.69'

COUNTY

N 01°02'26" W

N 74°10'44" E

307.69'

463.87'

20.00'

156.17'

N 80°38'25" E

130.33'

261.83'

131.50'

130.87'

RECEIVED BY

Umatilla County Surveyor

Date 1-8-80

Rec'd By ELS

No. B-18-A

E. 1/4 COR. SEC.
20, FD. 1/2" I.R.
11.80' EAST, SET
5/8" I.R., 1978
EDWARDS SURVEY

N 89°46'45" E 1191.11'

ECHOLS

ROAD

N 89°46'45" E 1324.00'

1185.36'

SURVEY FOR: EDWARD FERGUESON

LOCATION: S.E. 1/4, N.E. 1/4, SEC. 20, T4N, R28E.W.M.
UMATILLA COUNTY, OREGON

DATE: 11-8-79

SCALE: 1"=100'

● MONUMENTS FOUND

(000) OF RECORD

○ 1/2" IRON RODS SET

JOB N° S7909261

EDWARDS SURVEYING

567-3336

P.O. BOX 763

HERMISTON, OREGON

R-18-A