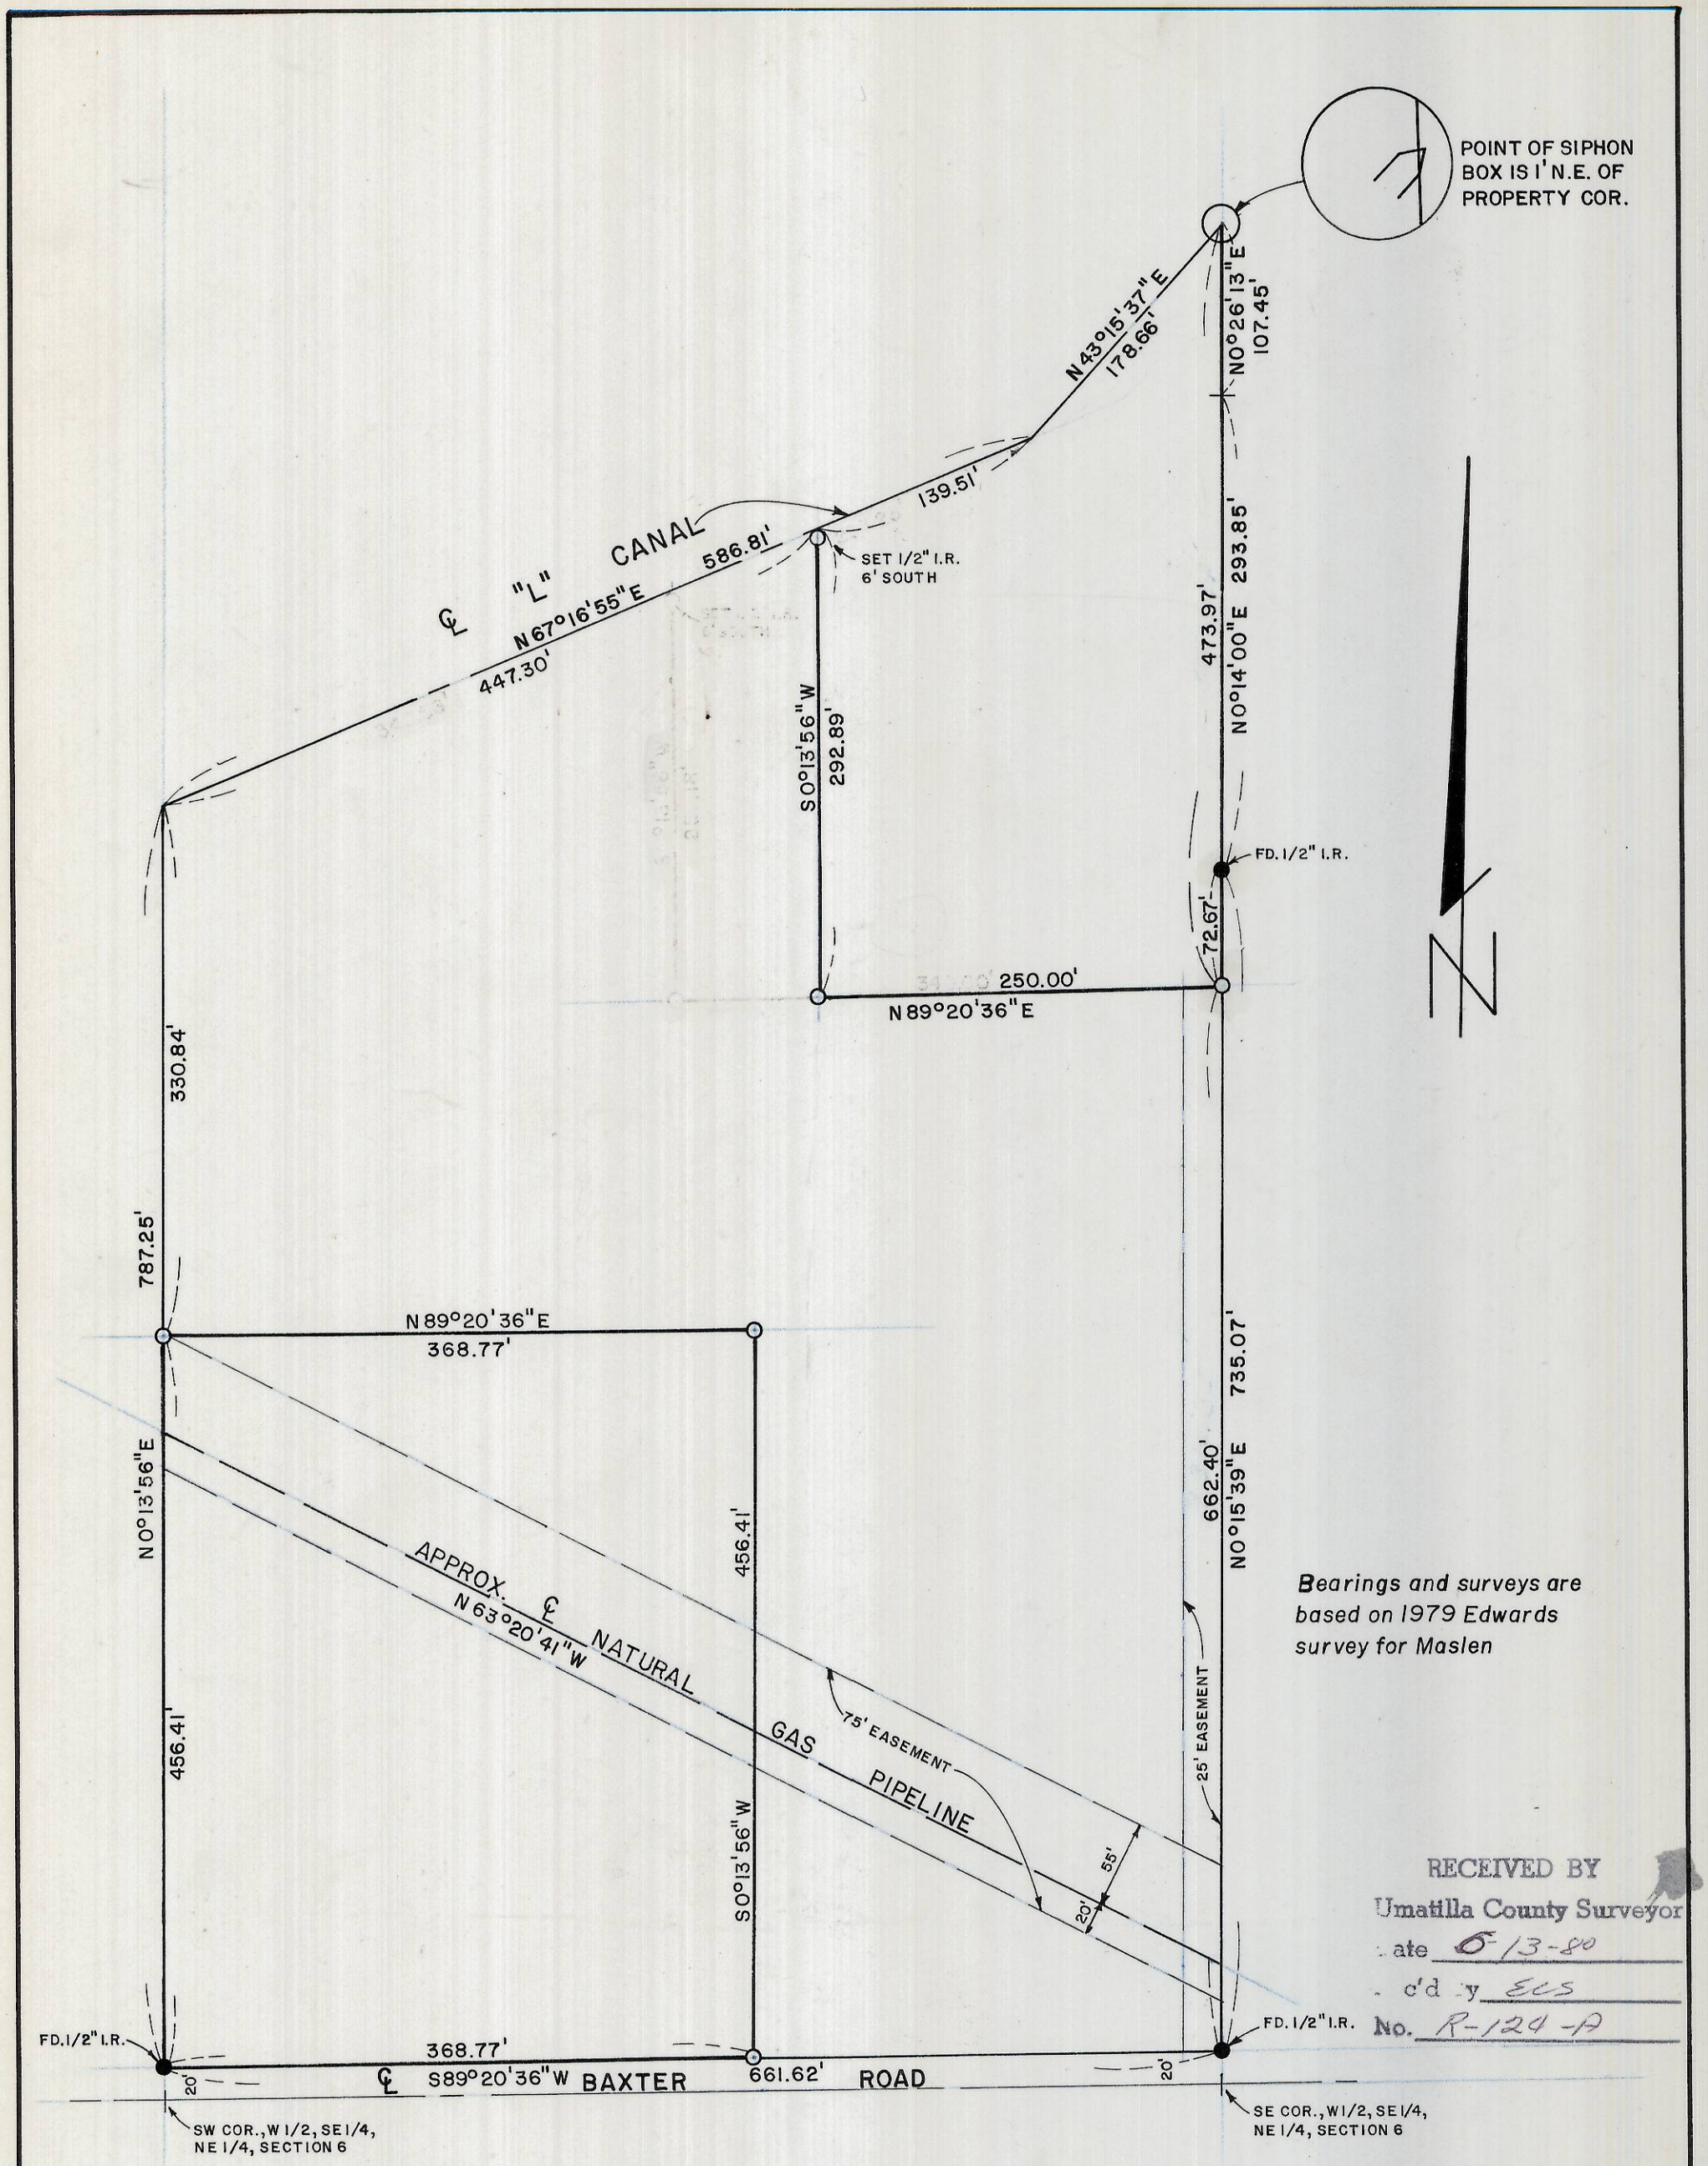

Bearings and surveys are based on 1979 Edwards survey for Maslen

RECEIVED BY
Umatilla County Surveyor
Date 6-13-80
C'd by ECS
No. R-124-A

REGISTERED PROFESSIONAL LAND SURVEYOR
G. Dennis Edwards
OREGON
JULY 16, 1971
G. DENNIS EDWARDS
951

SURVEY FOR: *ROY GROTZ*

LOCATION: NE 1/4, SEC. 6, T4N, R29 E., W.M.
UMATILLA COUNTY, OREGON

DATE: 5-21-80 — SCALE: 1"=100'

● MONUMENTS FOUND — (000) OF RECORD

O 1/2" IRON RODS SET — JOB Nº S7904094-B

EDWARDS SURVEYING — P.O. BOX 763
567-3336 — HERMISTON, OREGON

R-124-A