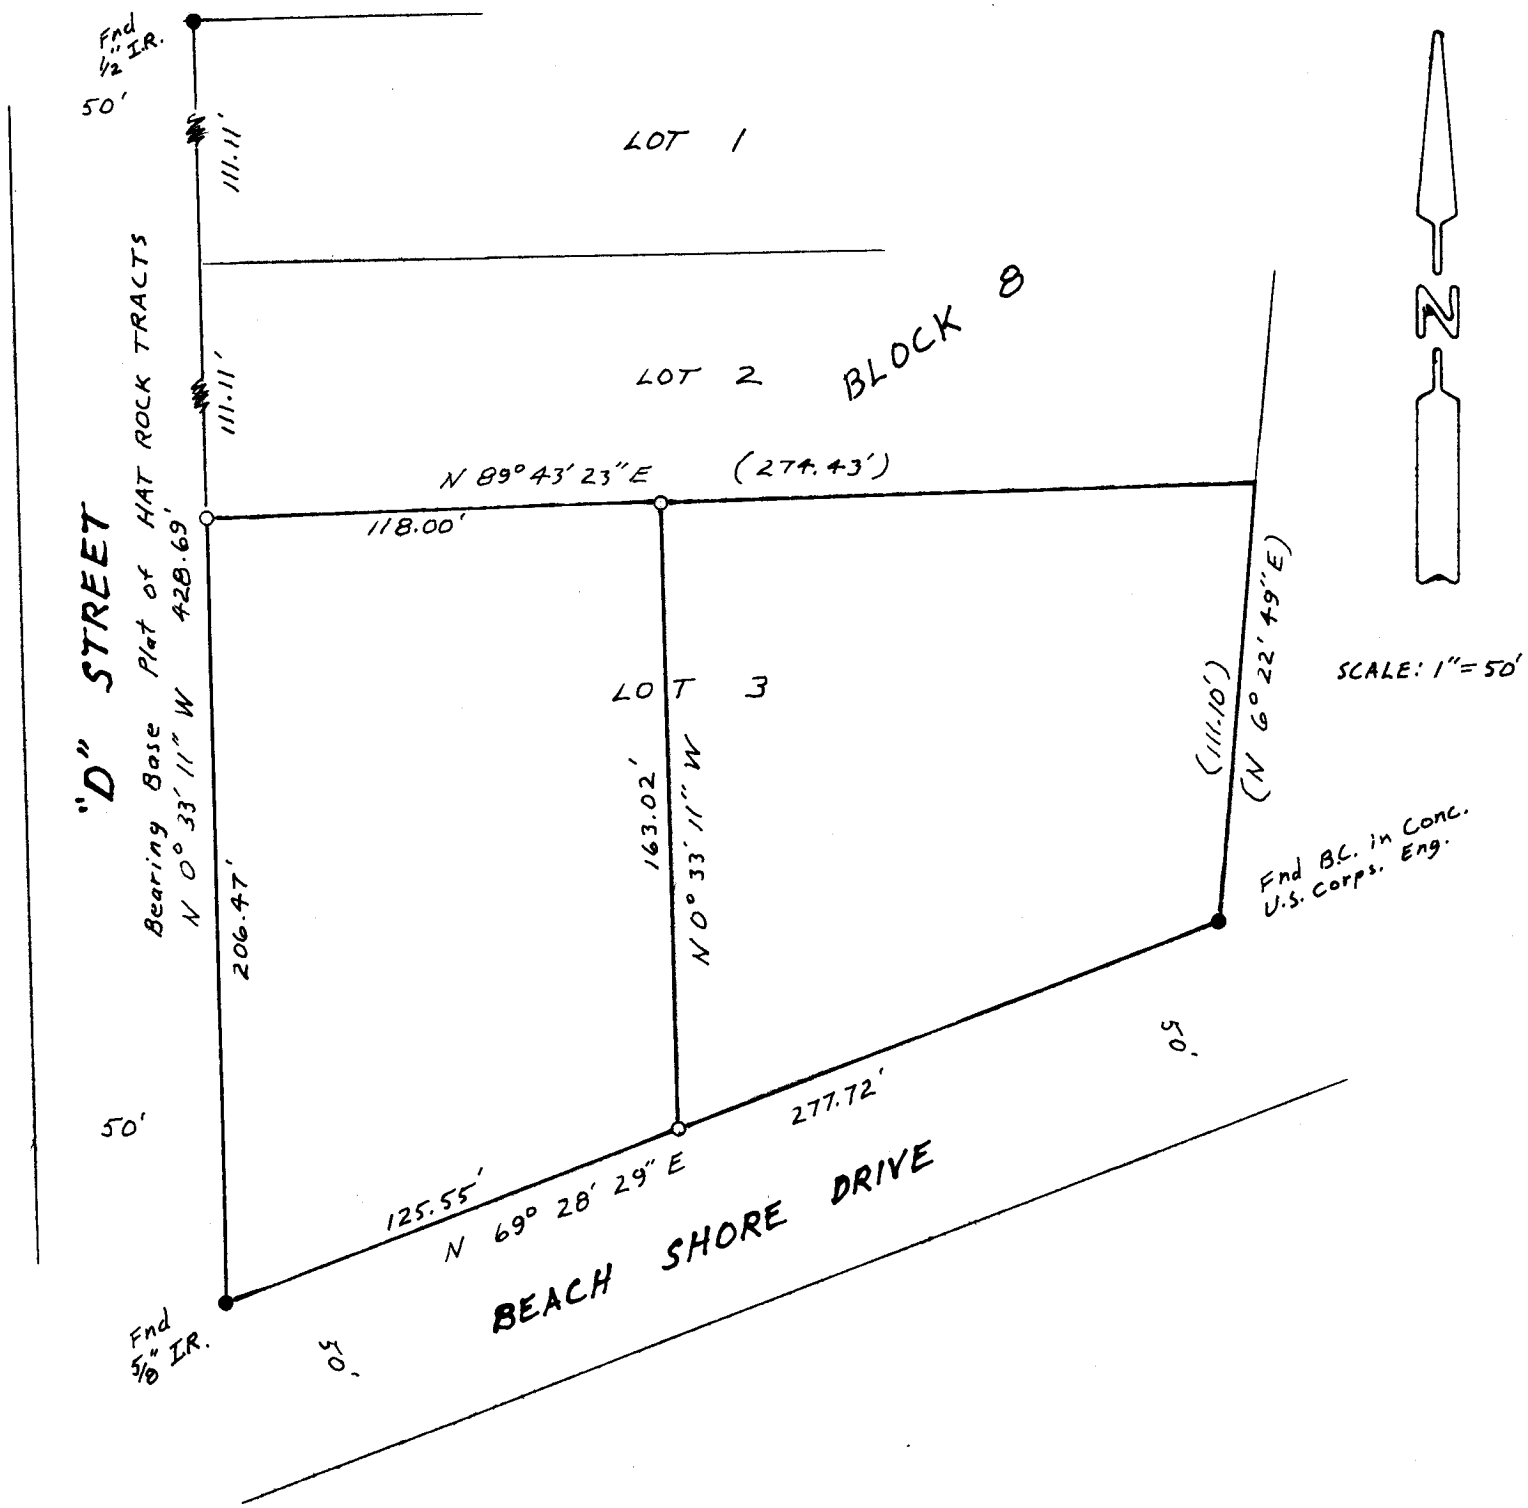

REGISTERED
PROFESSIONAL
LAND SURVEYOR

G. Dennis Edwards

OREGON
JULY 16, 1971
G. DENNIS EDWARDS
951

82-089-AY

SURVEY FOR ED STORZ
IN Lot 3, Blk 8, HAT ROCK TRACTS
IN NE¼, Sec 15, T5N, R29E, W.M.,
UMATILLA CO., OREGON
6/14/82 Job # S8206040
(000) of record o ½" IR's set.
EDWARDS SURVEYING P.O. Box 763
567-3336 HERMISTON, OR.