APPLICANTS NAME
ORVILLE SHOESHIPS

SITE NUMBER 17
DWELLING UNIT TYPE

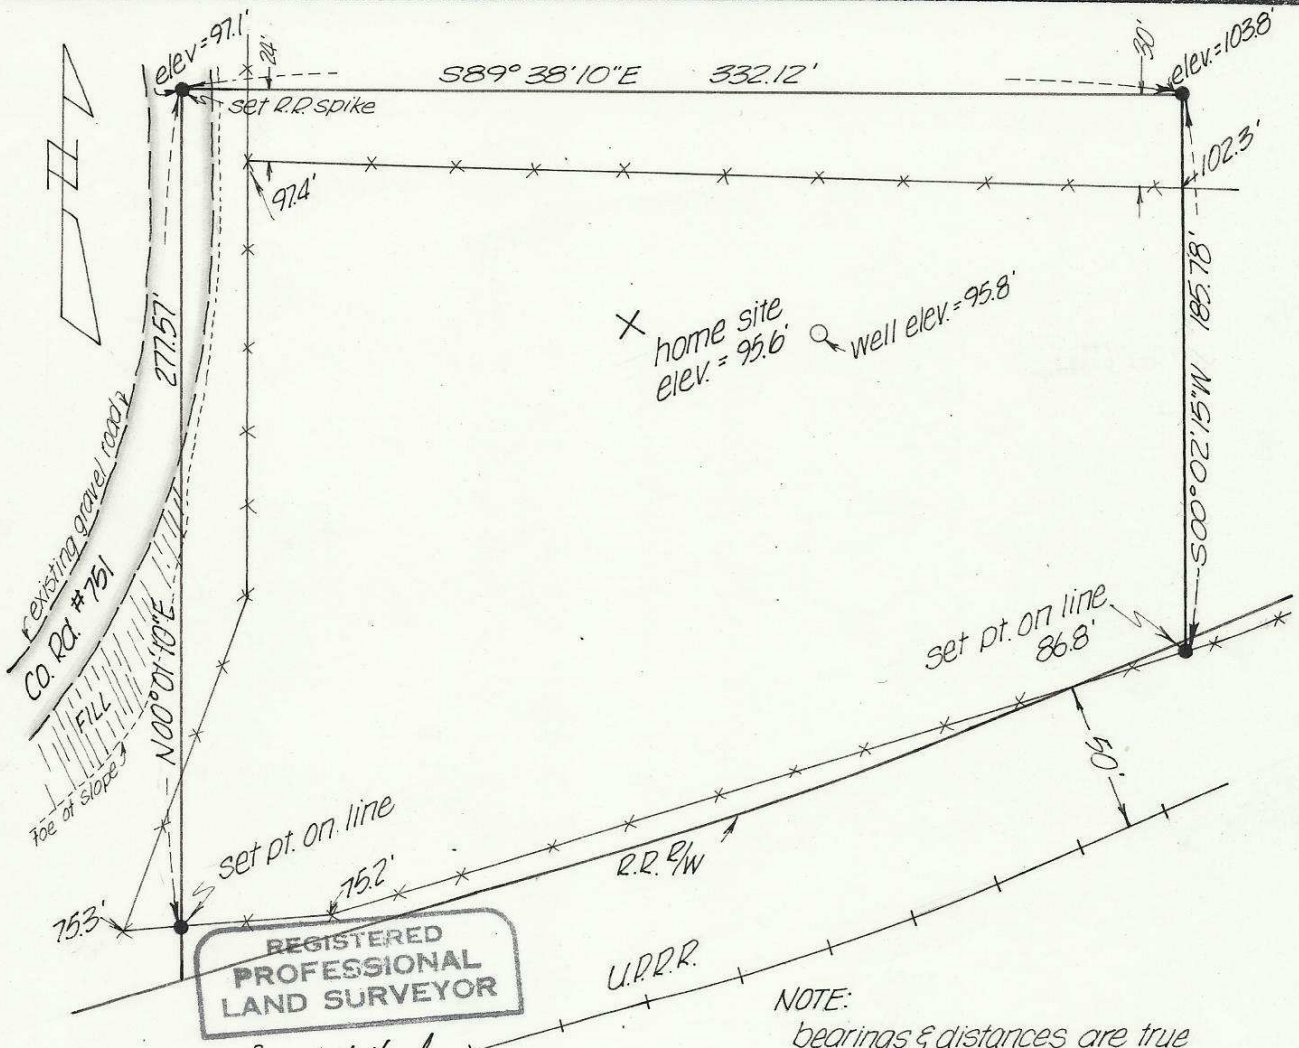

REGISTERED PROFESSIONAL LAND SURVEYOR

David H. Krumbein

OREGON JULY 17, 1970 DAVID H. KRUMBEIN 933

LEGEND:

● set 5/8" pin

■ R.R. milepost #237.45

NOTE:
bearings & distances are true based upon ties to N.G.S. sta. Mission & Homly. Elevations shown are local.

SECT. MAP

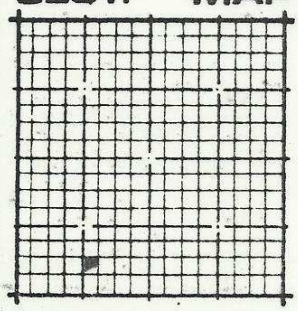

LEGAL DESCRIPTION

That portion of the West ½ of the West ½ of the Southeast ¼ of the Southwest ¼ Section 3, Township 2 North, Range 34 East W.M., lying North of the U.P.R.R. Right of Way. Excepting any and all Road Rights of Way.

NORTH
1" = 60'

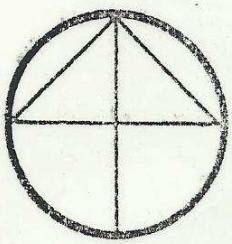

83-104-A4