

**SURVEY FOR MONTIE FLACK
IN BIK "A" HERMISTON ORCHARDS
ADD. TO CITY OF HERMISTON
IN SE 1/4 SEC 11, T4N, R2BE, W.M. UMATILLA
COUNTY, OREGON**

58605021 = Job # DATE 5/2/86
EDWARDS SURVEYING P.O. Box 763
567-3336 HERMISTON, OR.

RECEIVED BY
Umatilla County Surveyor
Date 6-17-86
Rec'd By JA
No. 86-60-AX


THE PURPOSE of this survey is to partition a building site out of the north part of Lot 18, BIK "A" HERMISTON ORCHARDS. I believe the monuments on 10th ST. were set by LaGier in a 1976 Sur. for MEYER.

SCALE: 1" = 100'

- Monuments Found
- 1/2" x 24" I. Rods set with Alum. Tag # 951 (000) of record. Plat of Hermiston ORCHARDS

DESCRIPTIONS:

- (A) LOT 18, Block "A" HERMISTON ORCHARDS. EXCEPTING THE SOUTH 137.50 feet & THE NORTH 15.00 feet.
- (B) THE SOUTH 137.50 feet of Lot 18, Block "A" HERMISTON ORCHARDS.

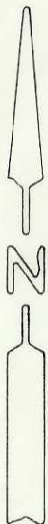


REGISTERED
PROFESSIONAL
LAND SURVEYOR

G. Dennis Edwards

OREGON
JULY 18, 1971
G. DENNIS EDWARDS
951

Fnd 1/2" IR, set
By me in 1978
sur. for Van Ripper

Fnd 1/2" IR
set by me
in 1978
Van Ripper Sur.

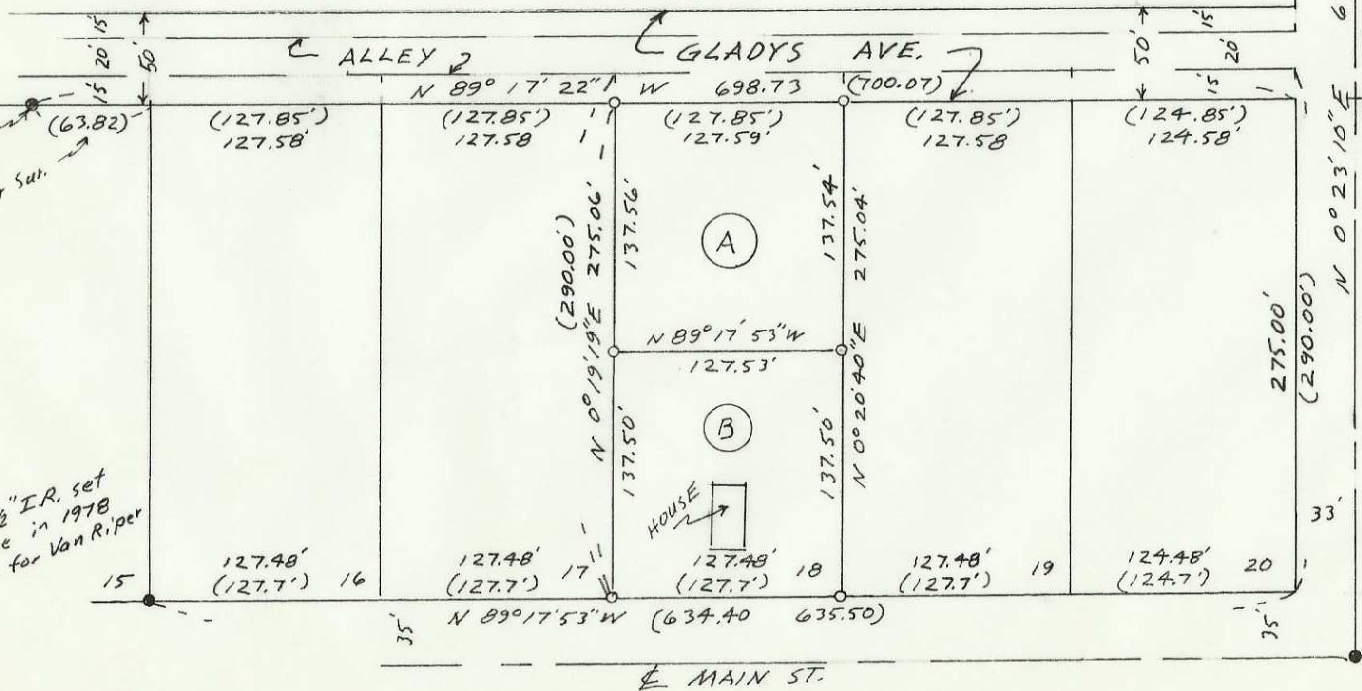

Bearing Base my 1978 sur.
for Van Ripper

Fnd 5/8" IR in
mon. Box

Fnd 5/8" IR in
mon. Box

86-60-AX