


David L. Haddock, Surveyor and Engineer
P.O. Box 1574 (541) 276-2174
Pendleton, OR. 97801

HADDOCK SURVEYING



GPS
ELECTRONIC TOTAL STATION

Surveyed: November 13, 1996

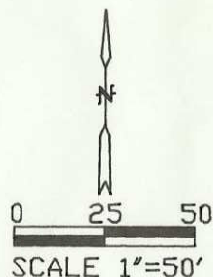

REGISTERED
PROFESSIONAL
LAND SURVEYOR


David L. Haddock

OREGON
JULY 12, 1968
DAVID L. HADDOCK
852

RENEWS 6-30-97

LEGEND:

● FOUND 5/8" IRON PIN

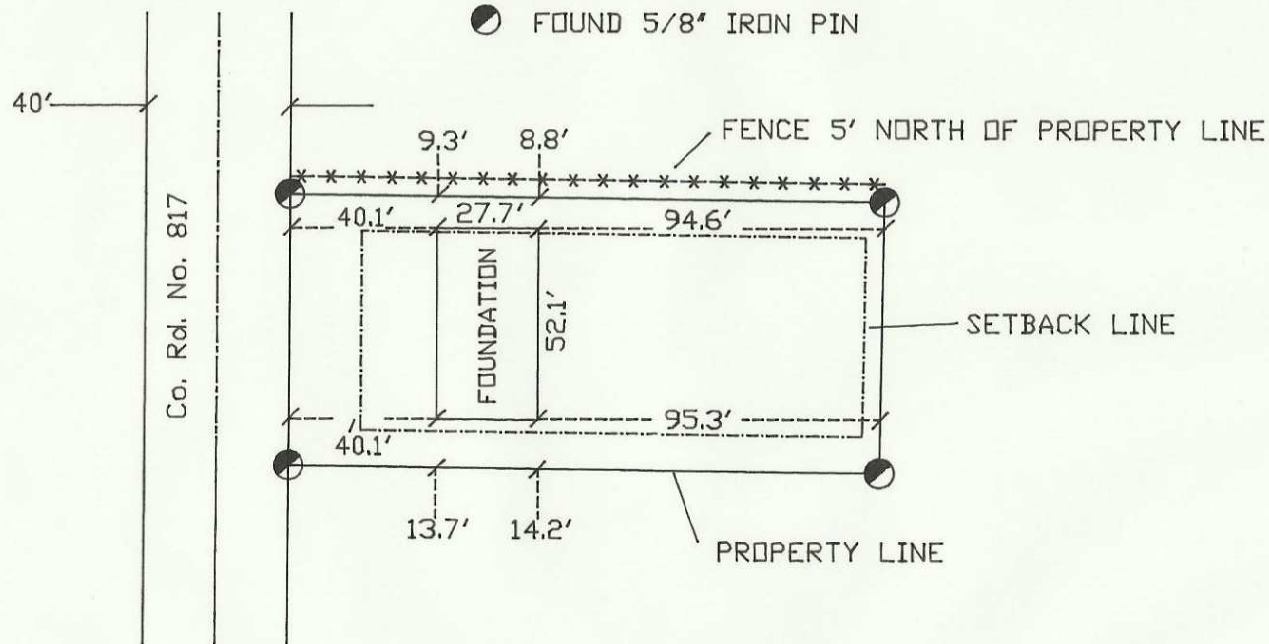

SURVEY FOR: TURN KEY HOMES, INC.
80857 HWY. 395 N.
HERMISTON, OR 97838
(541) 567-3026

JEFF BLAIR PROPERTY
512 NE 35th STREET
PENDLETON, OREGON

2N32 01 D

99-204-Ax