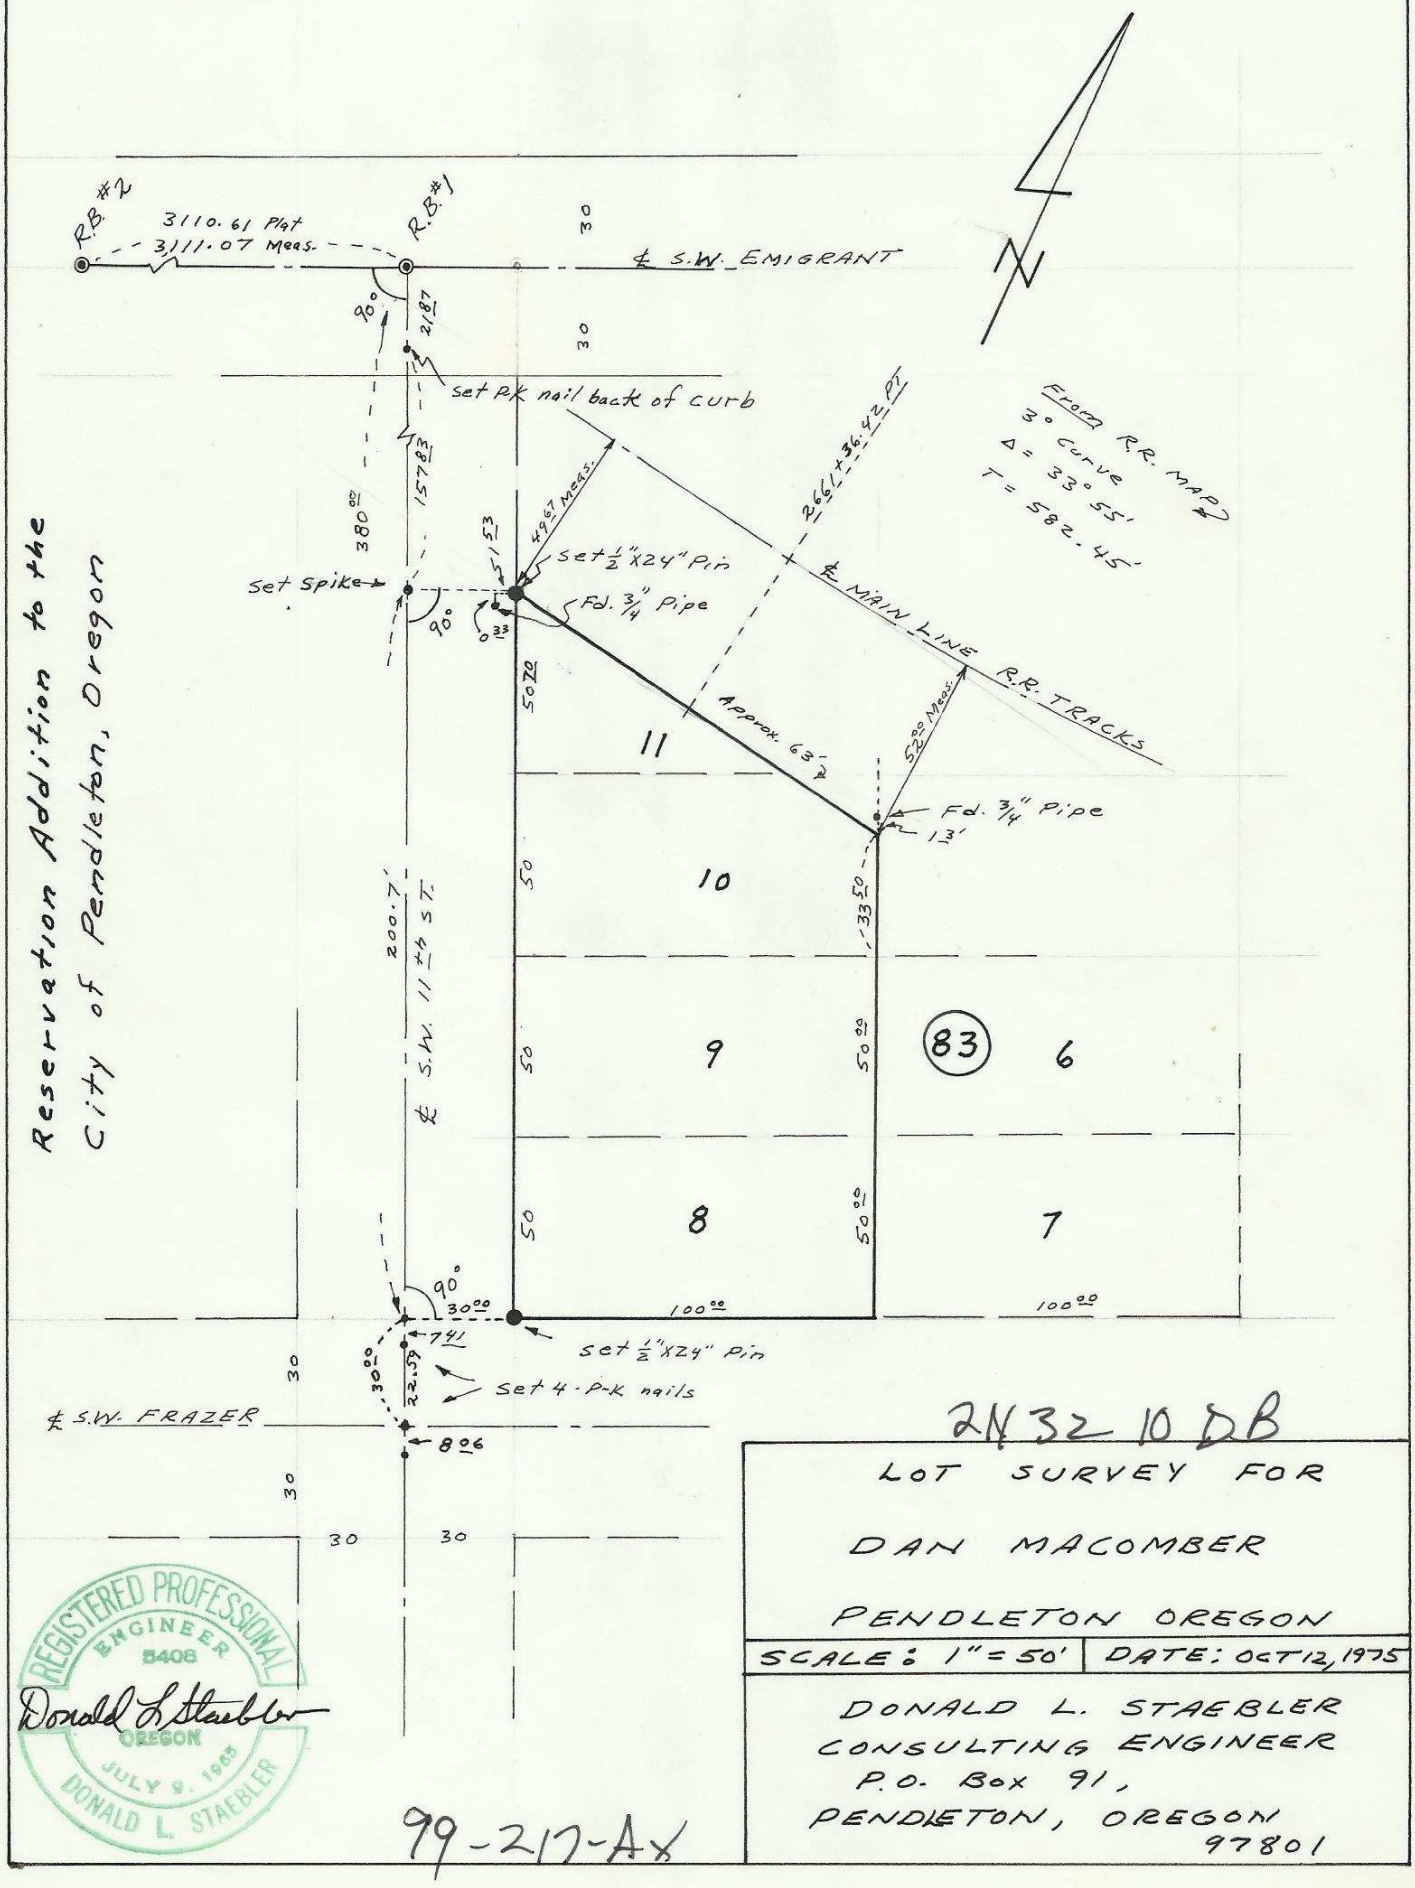

2N 32 10 DB

LOT SURVEY FOR

DAN MACOMBER

PENDLETON OREGON

SCALE: 1" = 50' | DATE: OCT 12, 1975

REGISTERED PROFESSIONAL ENGINEER 5408 OREGON JULY 9, 1965 DONALD L. STAEBLER

Donald L. Staebler

DONALD L. STAEBLER
CONSULTING ENGINEER
P.O. Box 91,
PENDLETON, OREGON
97801

99-217-Ax