GORDON'S TRACTS

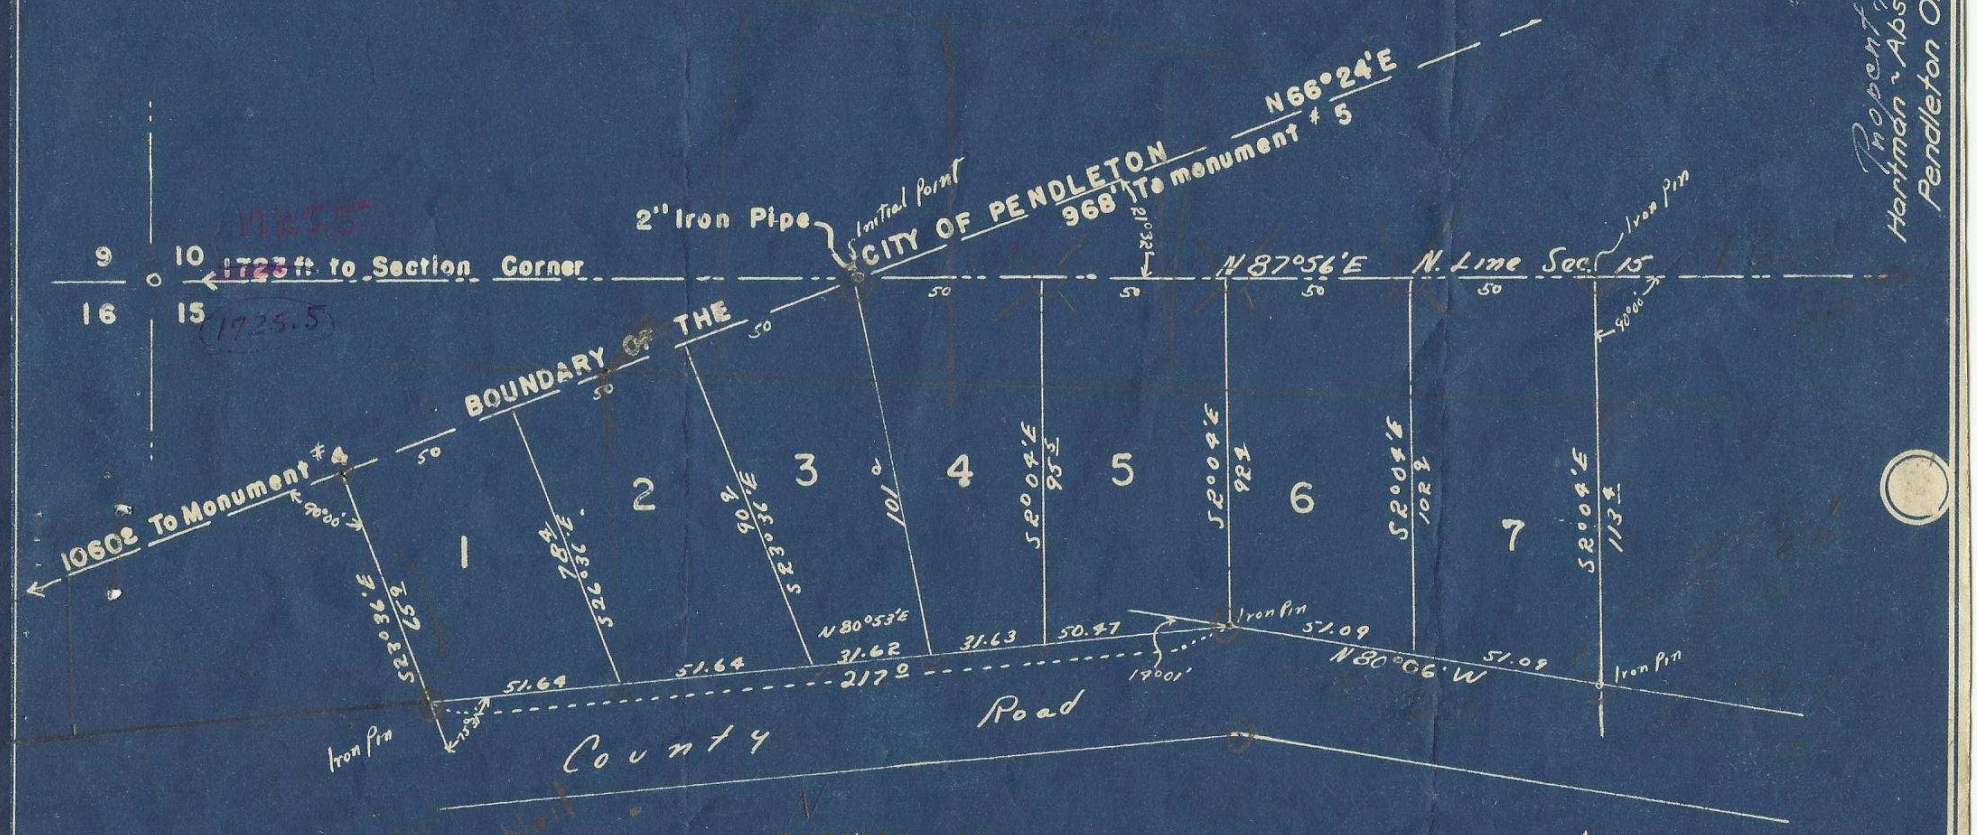

SECTION 15

T2N, R32 E.W.M.

CITY OF PENDLETON, UMATILLA COUNTY OREGON

SCALE 1" = 50'

1949

Property of
Hartman-Abstract Co.,
Pendleton Oregon