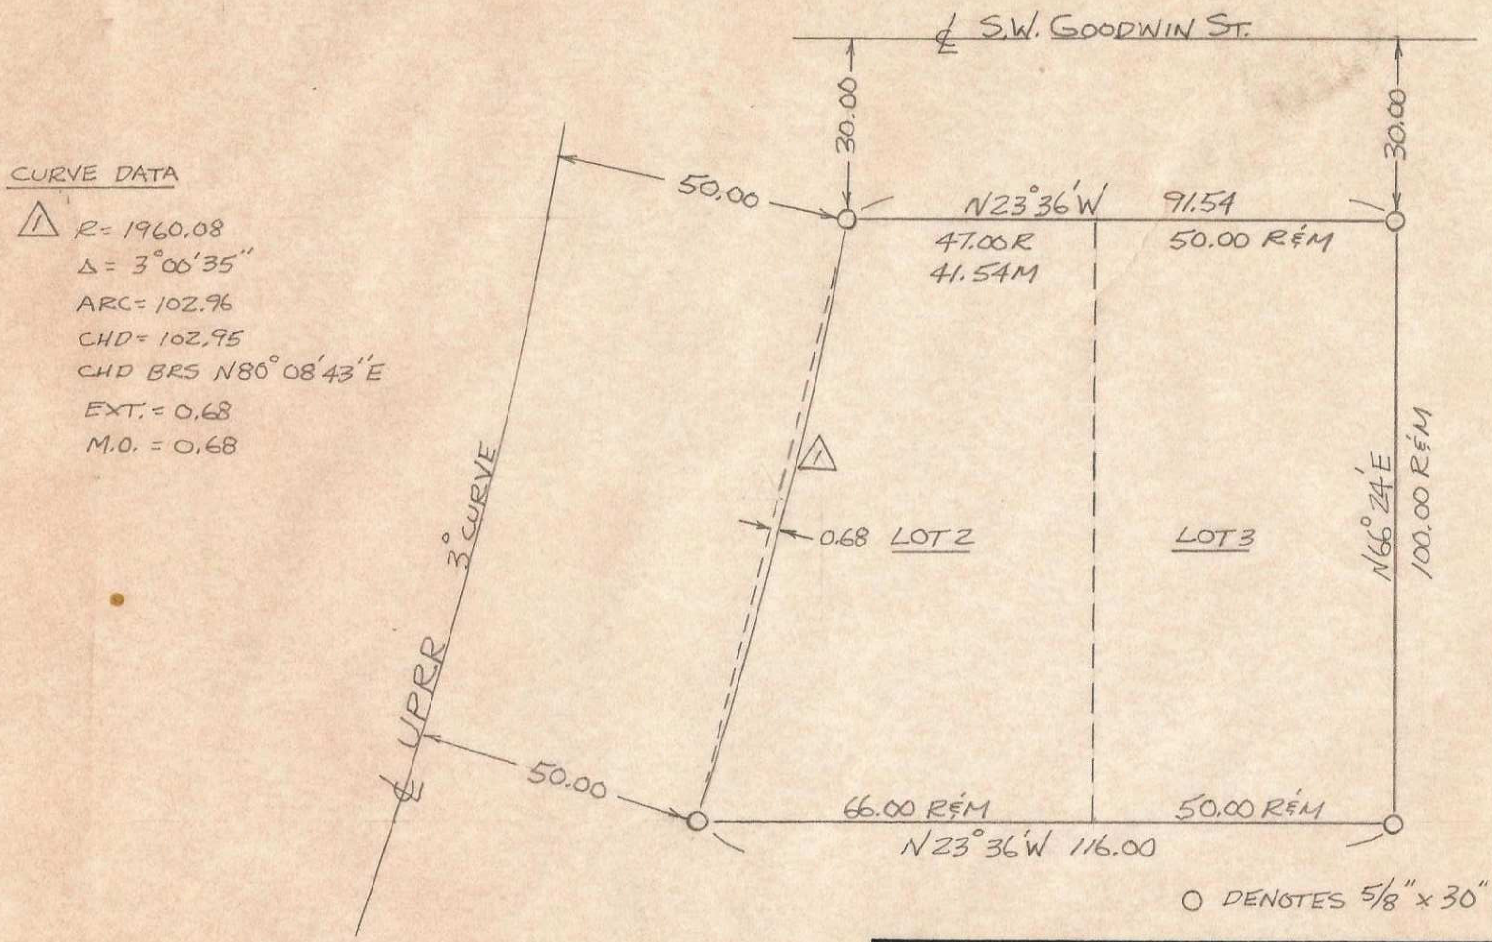

WAYNE HARRIS CO., INC.

SCALE: 1" = 30'	APPROVED BY:	DRAWN BY FSM
DATE: 13 OCT 80		REVISED

SURVEY FOR KEN LEDREW - LOTS 2 & 3, BLK 108, RESERVATION ADD., PENDLETON, OREGON

T2N R32E Sec. 10 DB

DRAWING NUMBER 80-455A

8½X11 PRINTED ON NO. 1000H CLEARPRINT

02-223-A8