




REGISTERED
PROFESSIONAL
LAND SURVEYOR

Howard L. Smith Jr.

OREGON
OCT. 4, 1977
HOWARD L. SMITH, JR.
1473

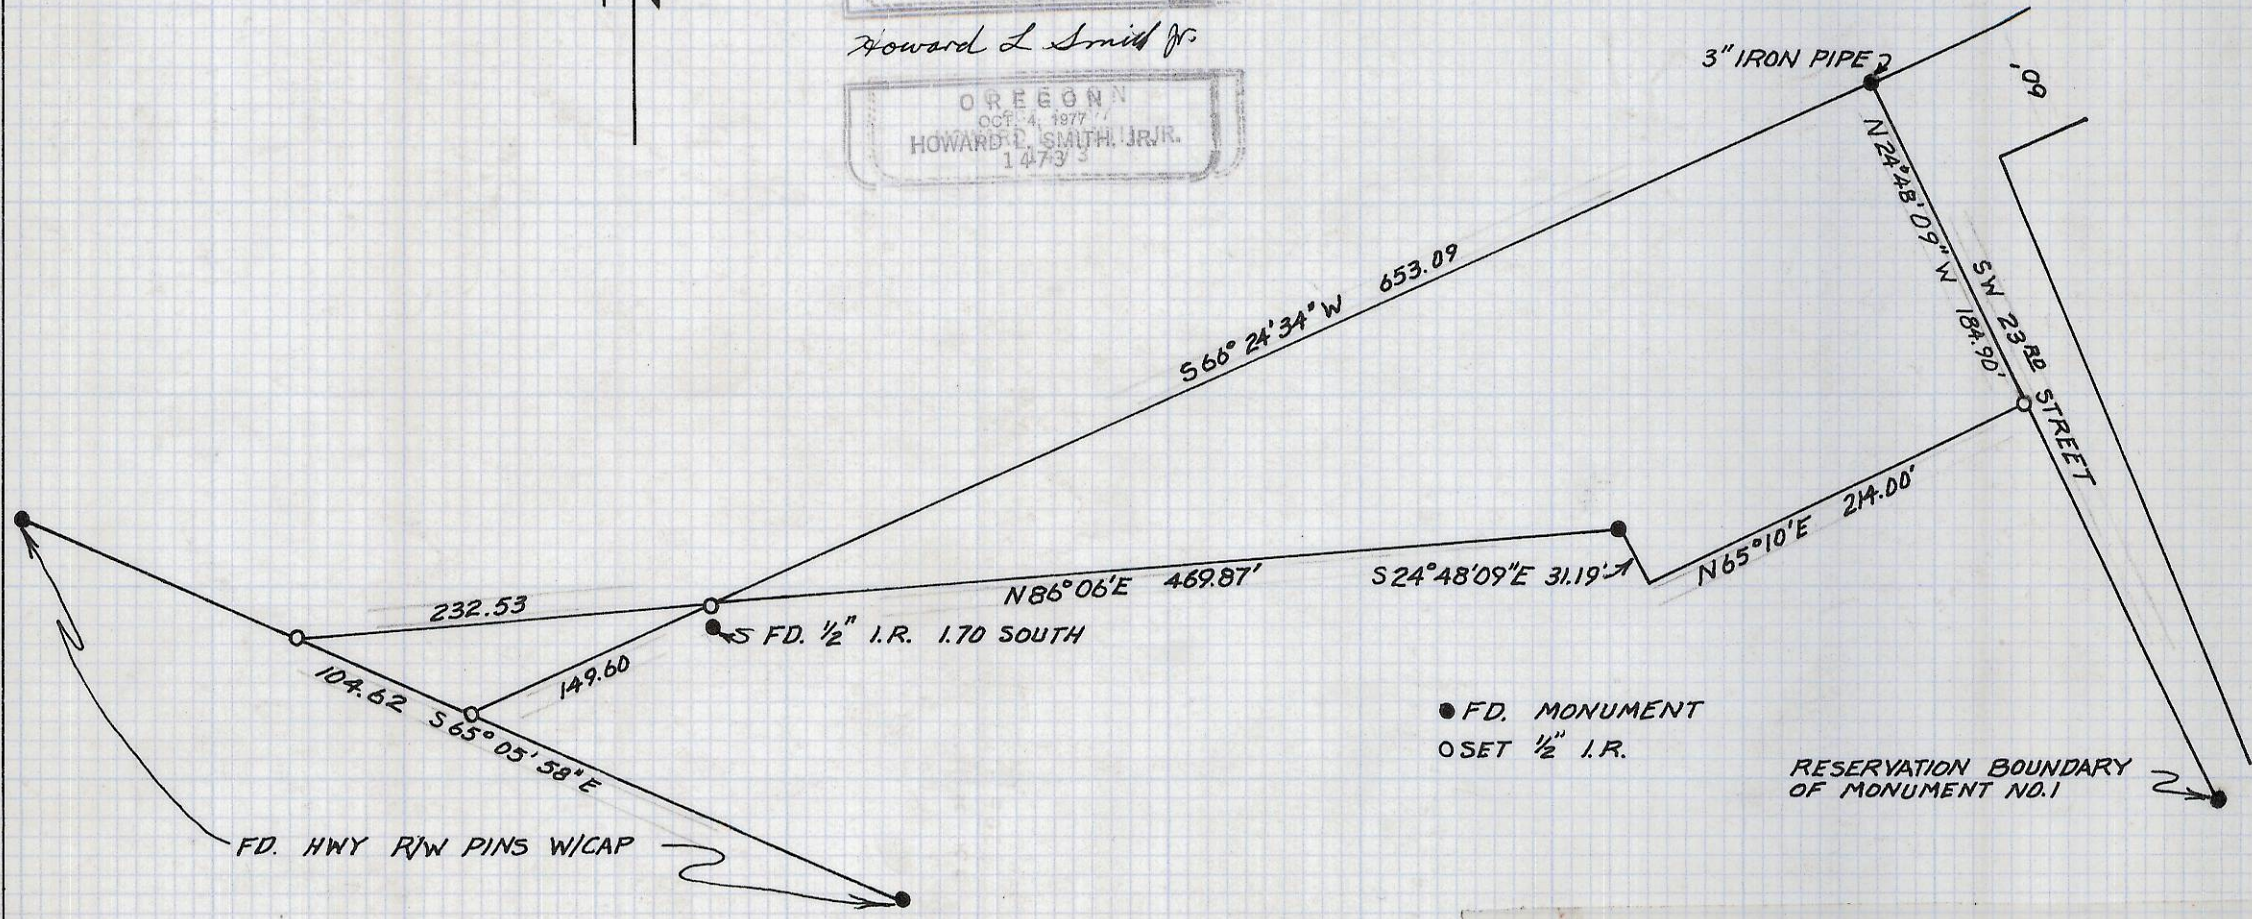

● FD. MONUMENT
OSET 1/2" I.R.

RESERVATION BOUNDARY
OF MONUMENT NO. 1

FD. HWY R/W PINS W/CAP

SURVEY FOR
HARRIS PINE MILLS
SECTION 9, T2N, R32E, WM
PENDLETON, OREGON

WAYNE HARRIS CO. INC.				
ENGINEERS-SURVEYORS			PENDLETON, ORE	
SCALE	DATE	DWN	CHK	DWG. NO
1"=100'	2-24-78	ABC	WOH	78-407A

02-229-Ax