


VERNON B. TENNESON & ASSOCIATES

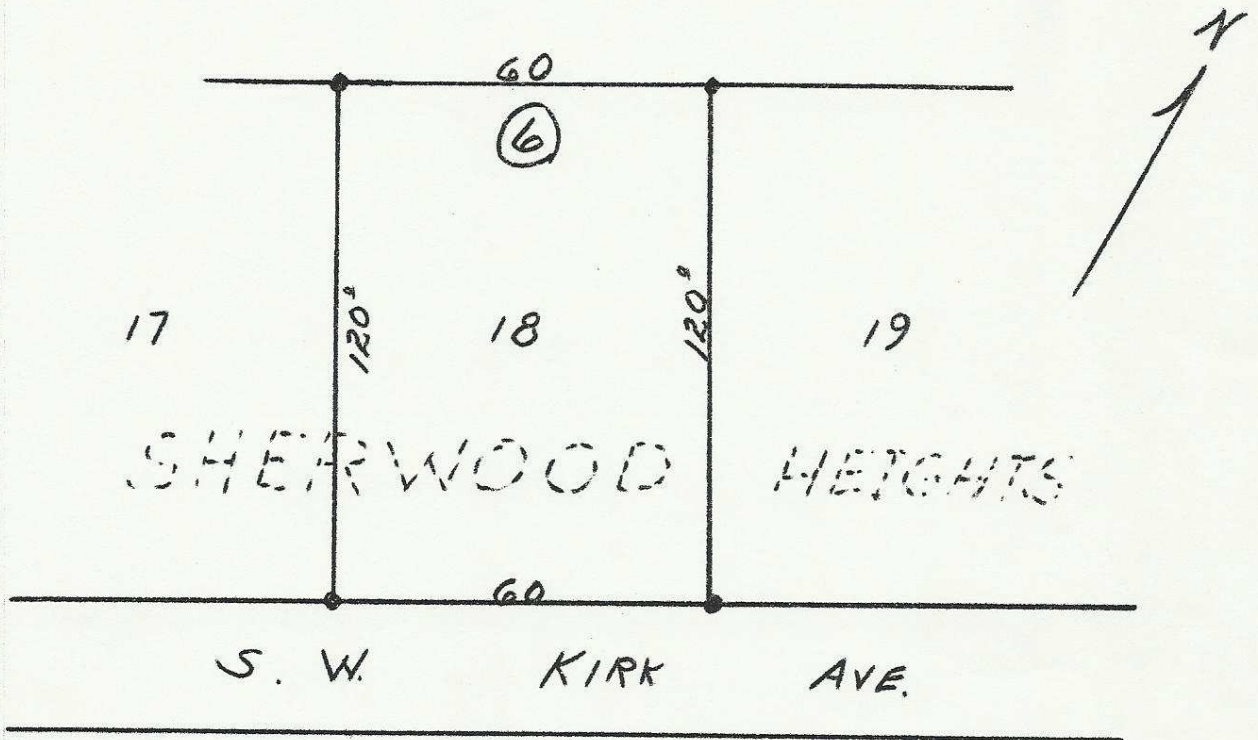

• 1/2" x 24" IRON PIN

TRN 32 16AB

04-194-Ax

