


North Line
Lassen's Sub-
Division

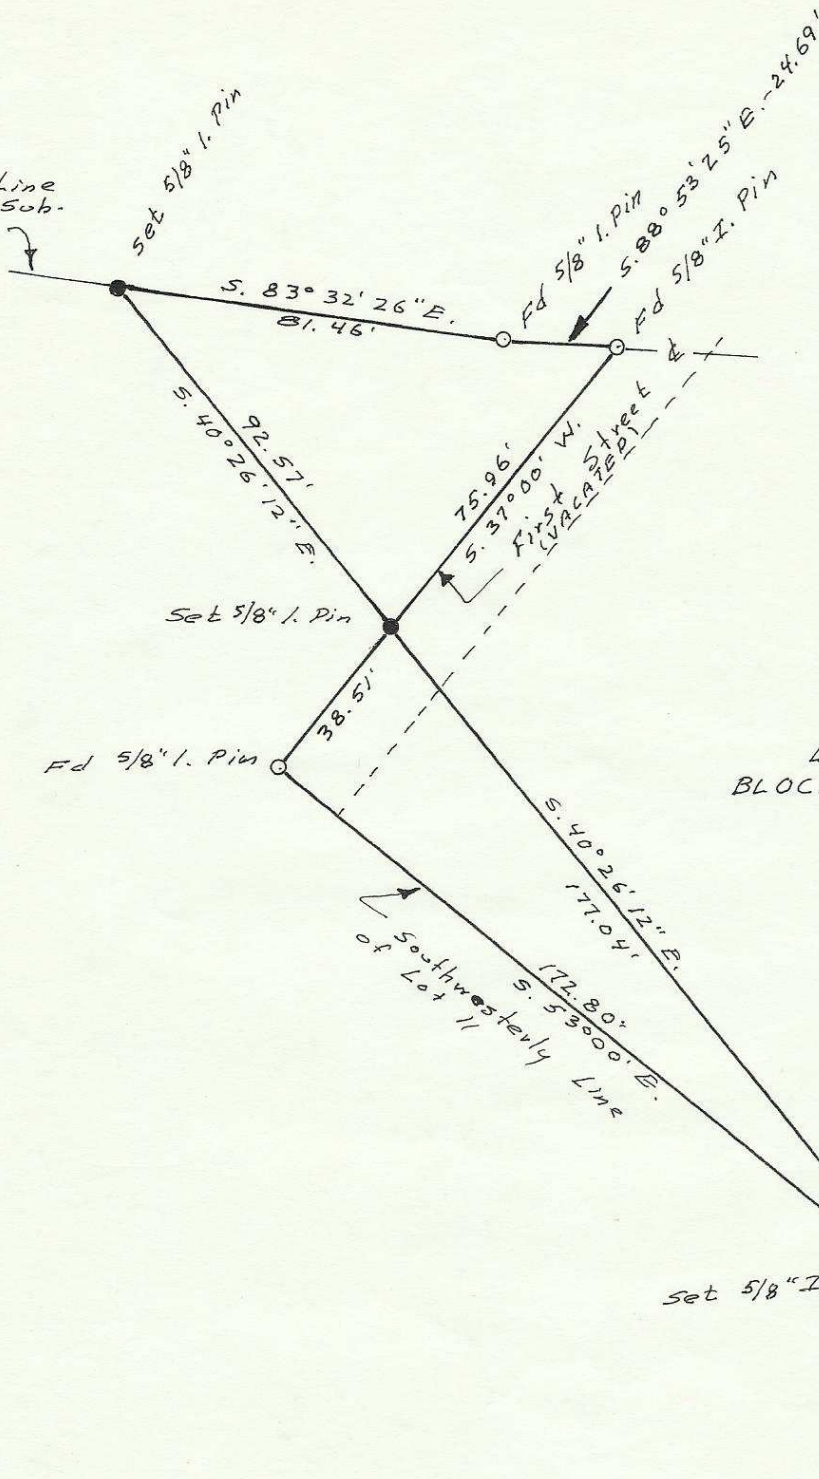

Lot 11
BLOCK 1, LASSENS SUBDIVISION


BK 321
PG 130

BK 160
PG 388a

Set 5/8" I. Pin

Fd. 5/8" I. Pin

N.W.
r/w Line, H.W. # 11

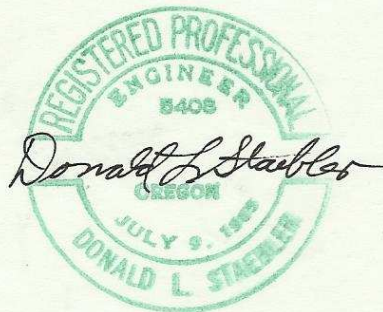

2NS2 ICD

TRACT SURVEY FOR
ROLAND HAERTL, P.E.
PROJECT MANAGEMENT, INC.
2187 S.W. MAIN ST.
PORTLAND, OREGON.

SCALE: 1" = 50'

DATE: 7-30-75

DONALD L. STAEBLER
CONSULTING ENGINEER
P.O. BOX 91

PENDLETON OREGON 97801

06-42-AX