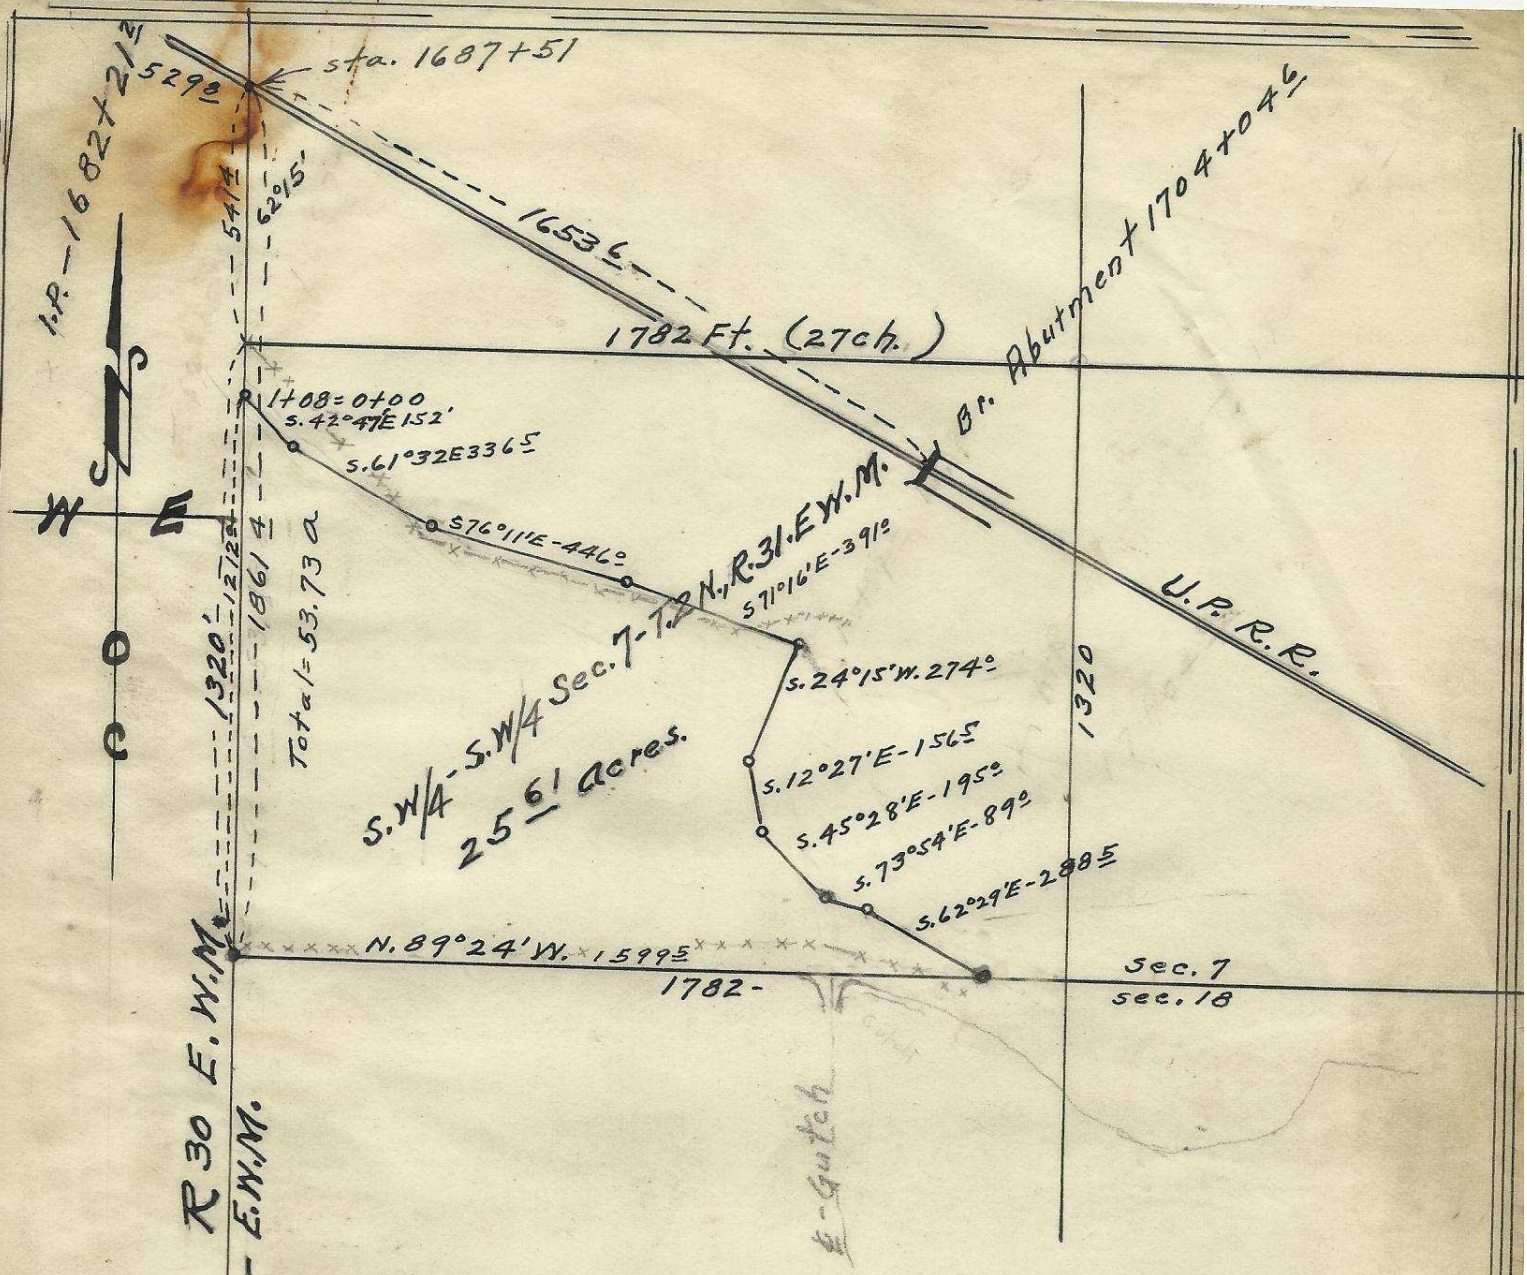

REGISTERED PROFESSIONAL ENGINEER 1497 W. E. O. Criger OREGON MAR. 9, 1931 W. E. O. CRIGER

06-128-A

Plat of S.W/4 of S.W/4 of Sec. 7 - T. 2 N., R. 31 E W.M. Approx. 26 a. above high water surveyed, staked & platted Oct. 19[illegible] By - W. E. O. Criger.

Const = 14" = 3.68 a. Scale: 1" = 400'

6.96 = 25 61 Acres.

Lewis Livestock Co. - Geo. Corey (4)
Box - 776 - Pen. Phone 134+3971-