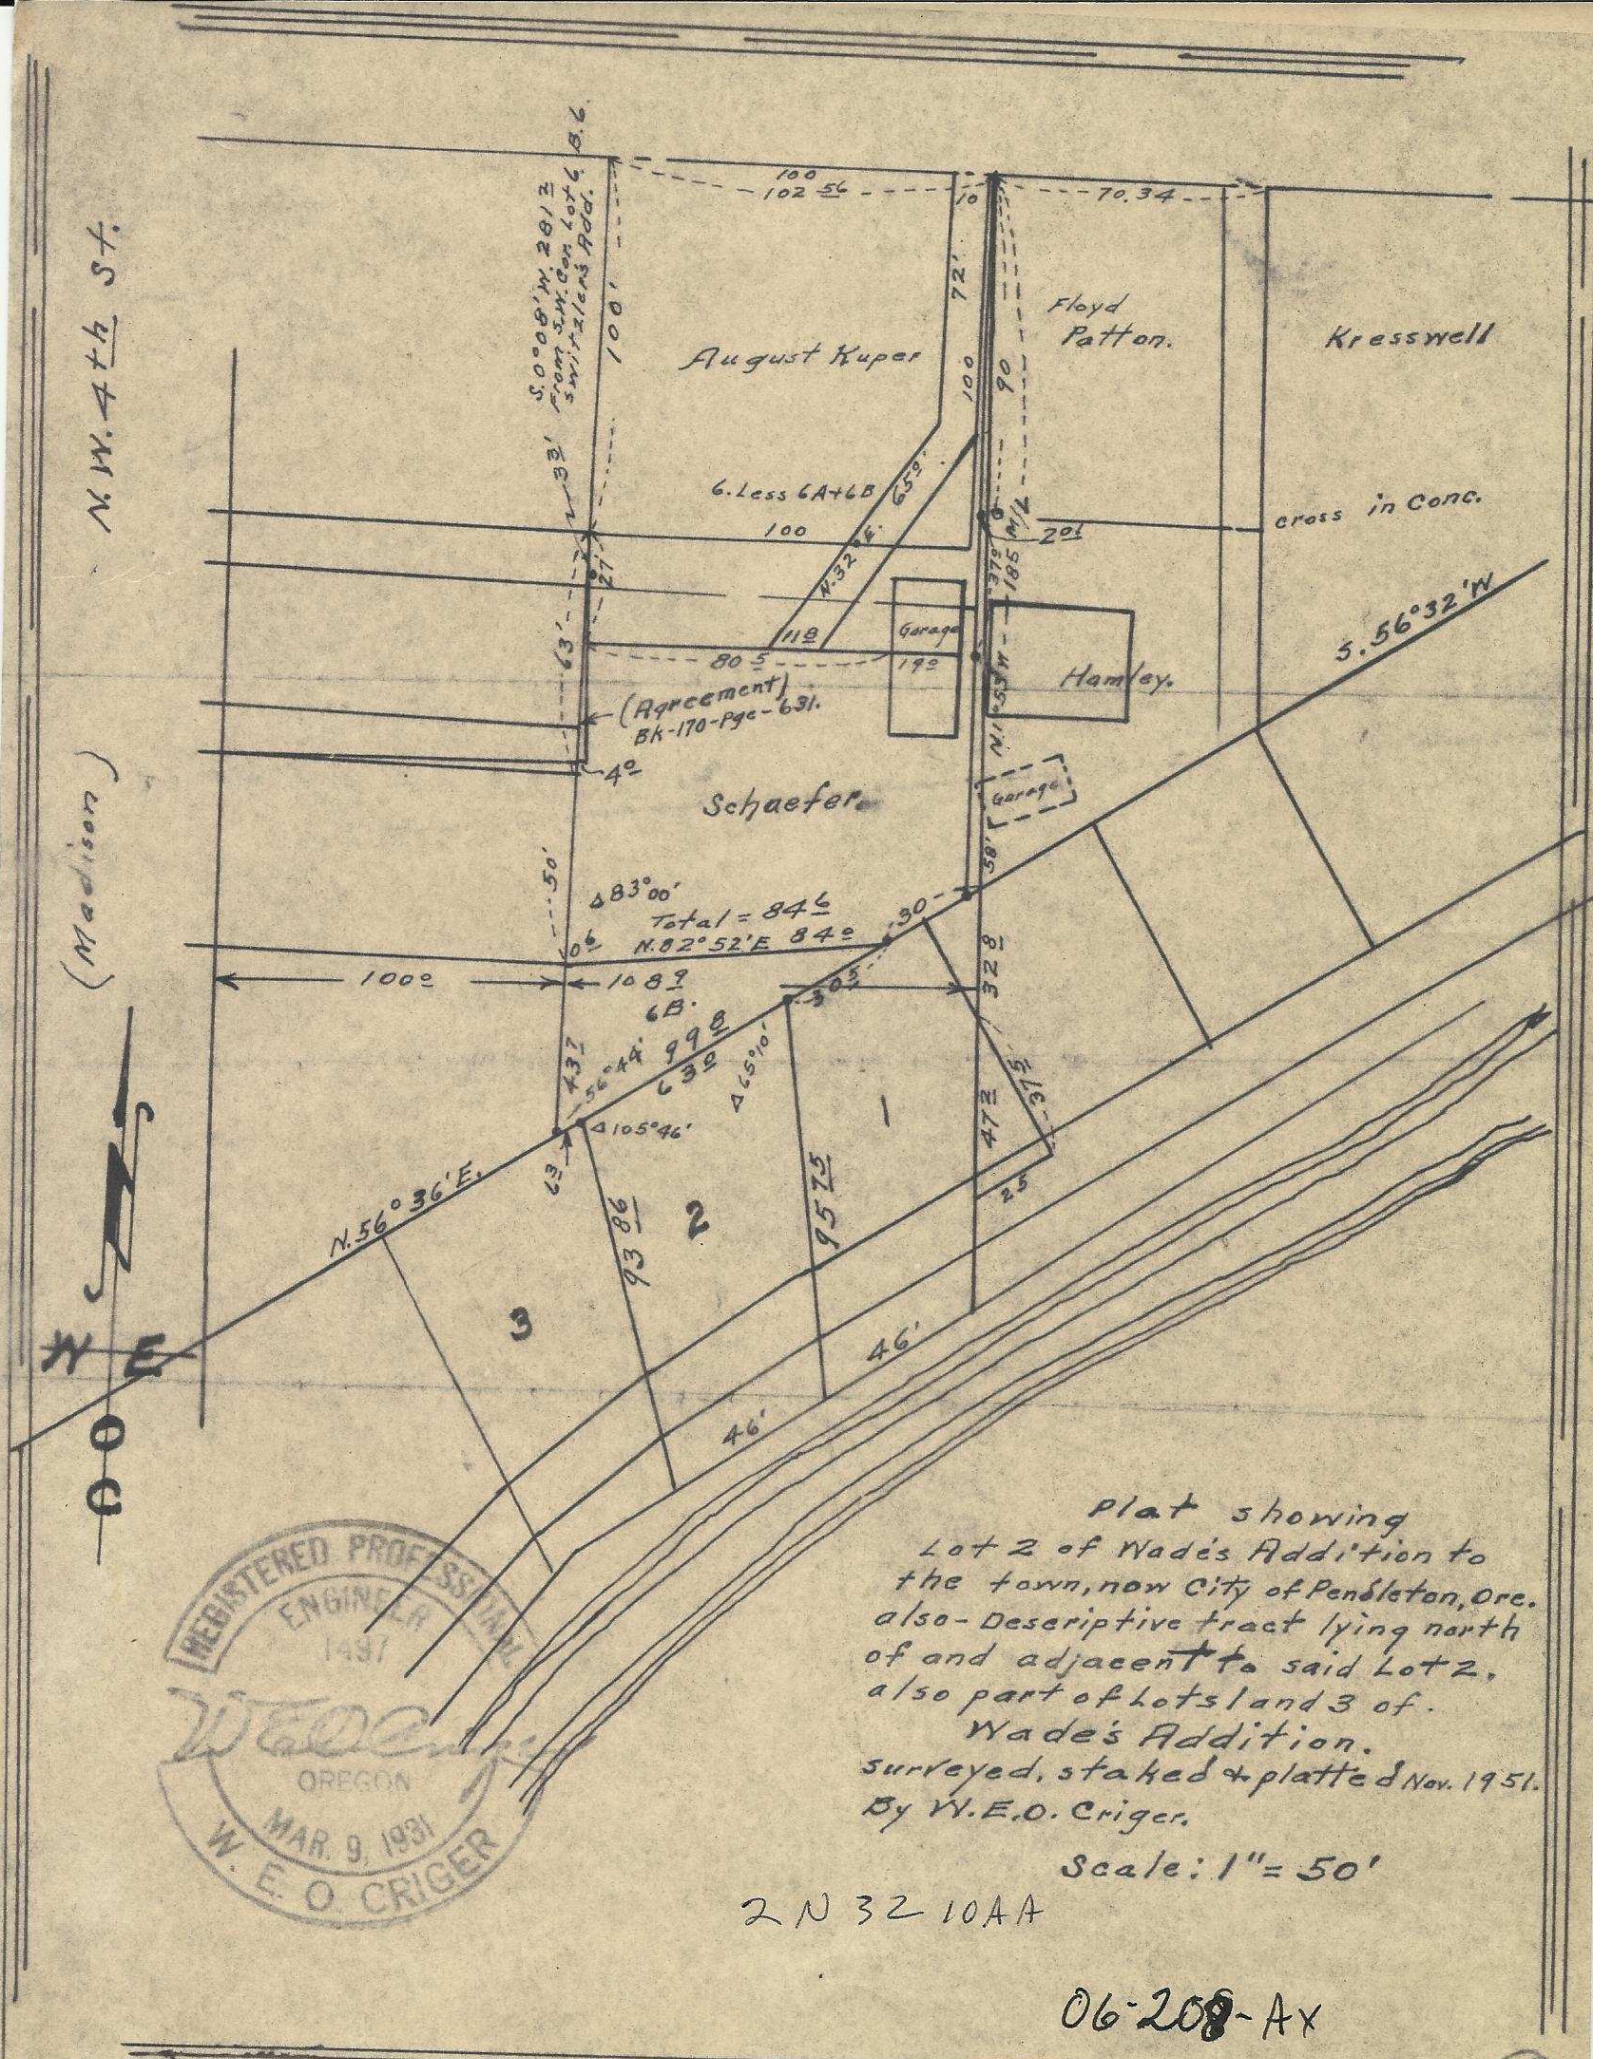

Plat showing
Lot 2 of Wade's Addition to the town, now City of Pendleton, Ore. also - Descriptive tract lying north of and adjacent to said Lot 2, also part of Lots 1 and 3 of Wade's Addition.
Surveyed, staked & platted Nov. 1951.
By W.E.O. Criger.

Scale: 1" = 50'

REGISTERED PROFESSIONAL ENGINEER 1497 OREGON MAR. 9, 1931 W. E. O. CRIGER

2N 32 10AA

06-208-Ax

4