
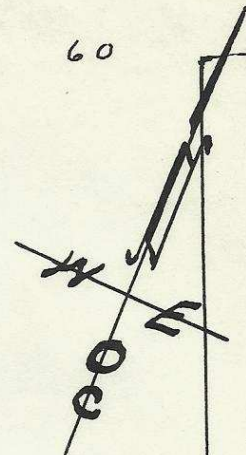


S.W. ISAAC AVE. 60'

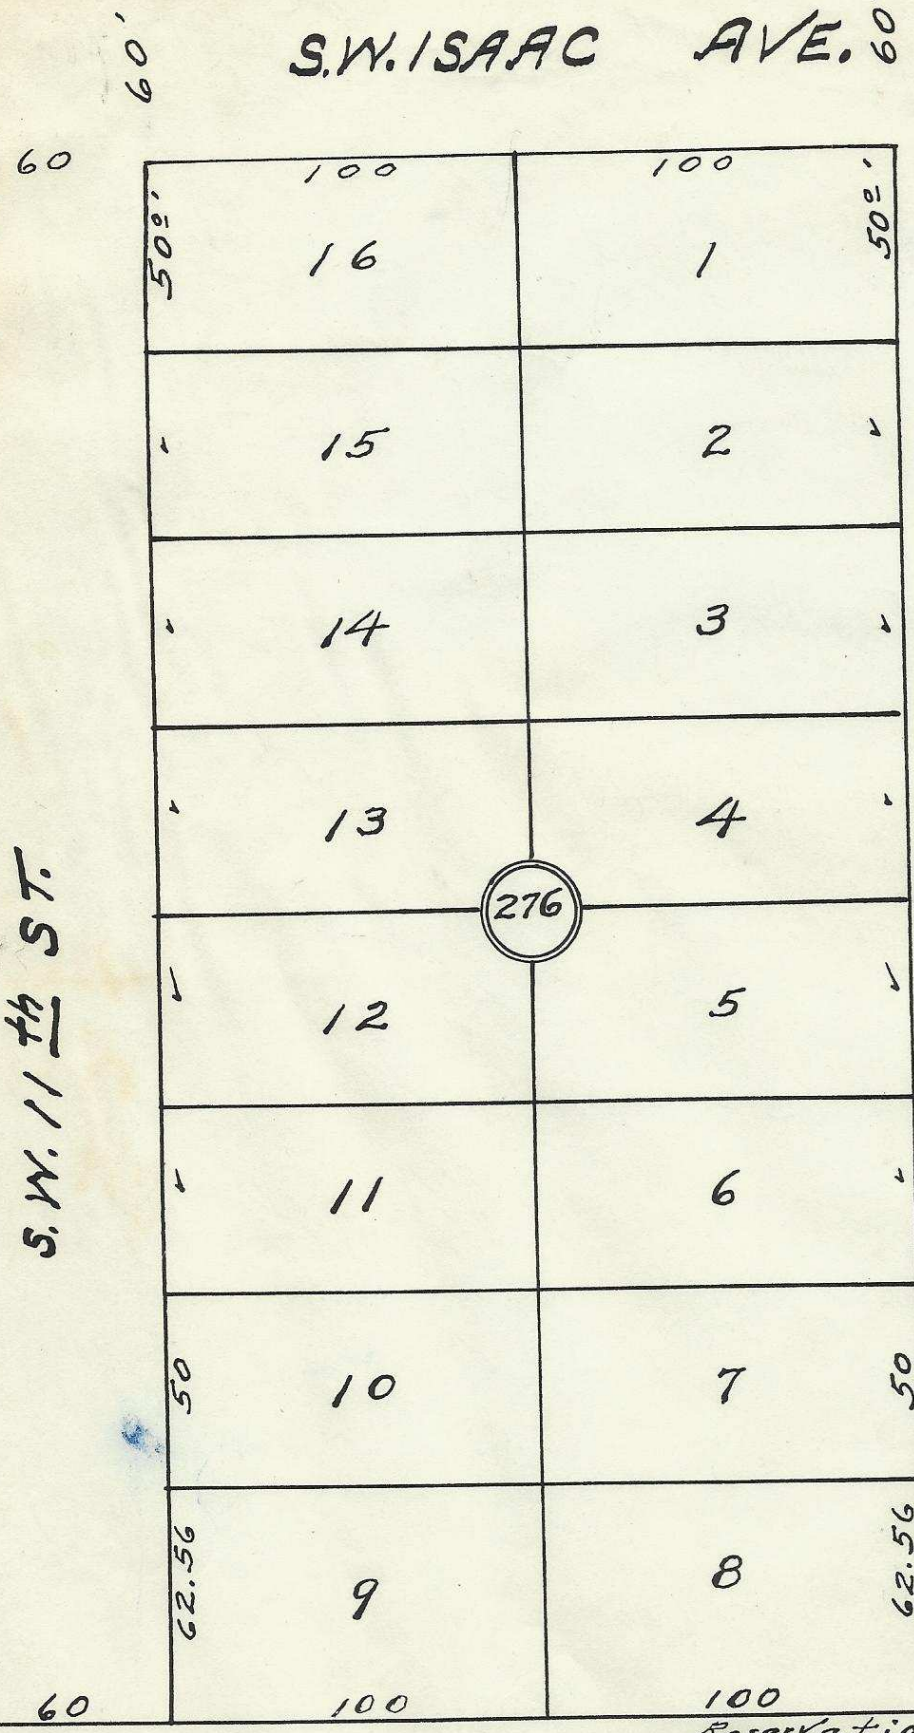


S.W. 11th St.

S.W. 10th St.



276

Reservation Boundary

06-281-Ax

L.V. Carr - 1, 2, 3, 4 - 13 to 16. - (McKay Co.)

Chas. McQuinn - 14-2