


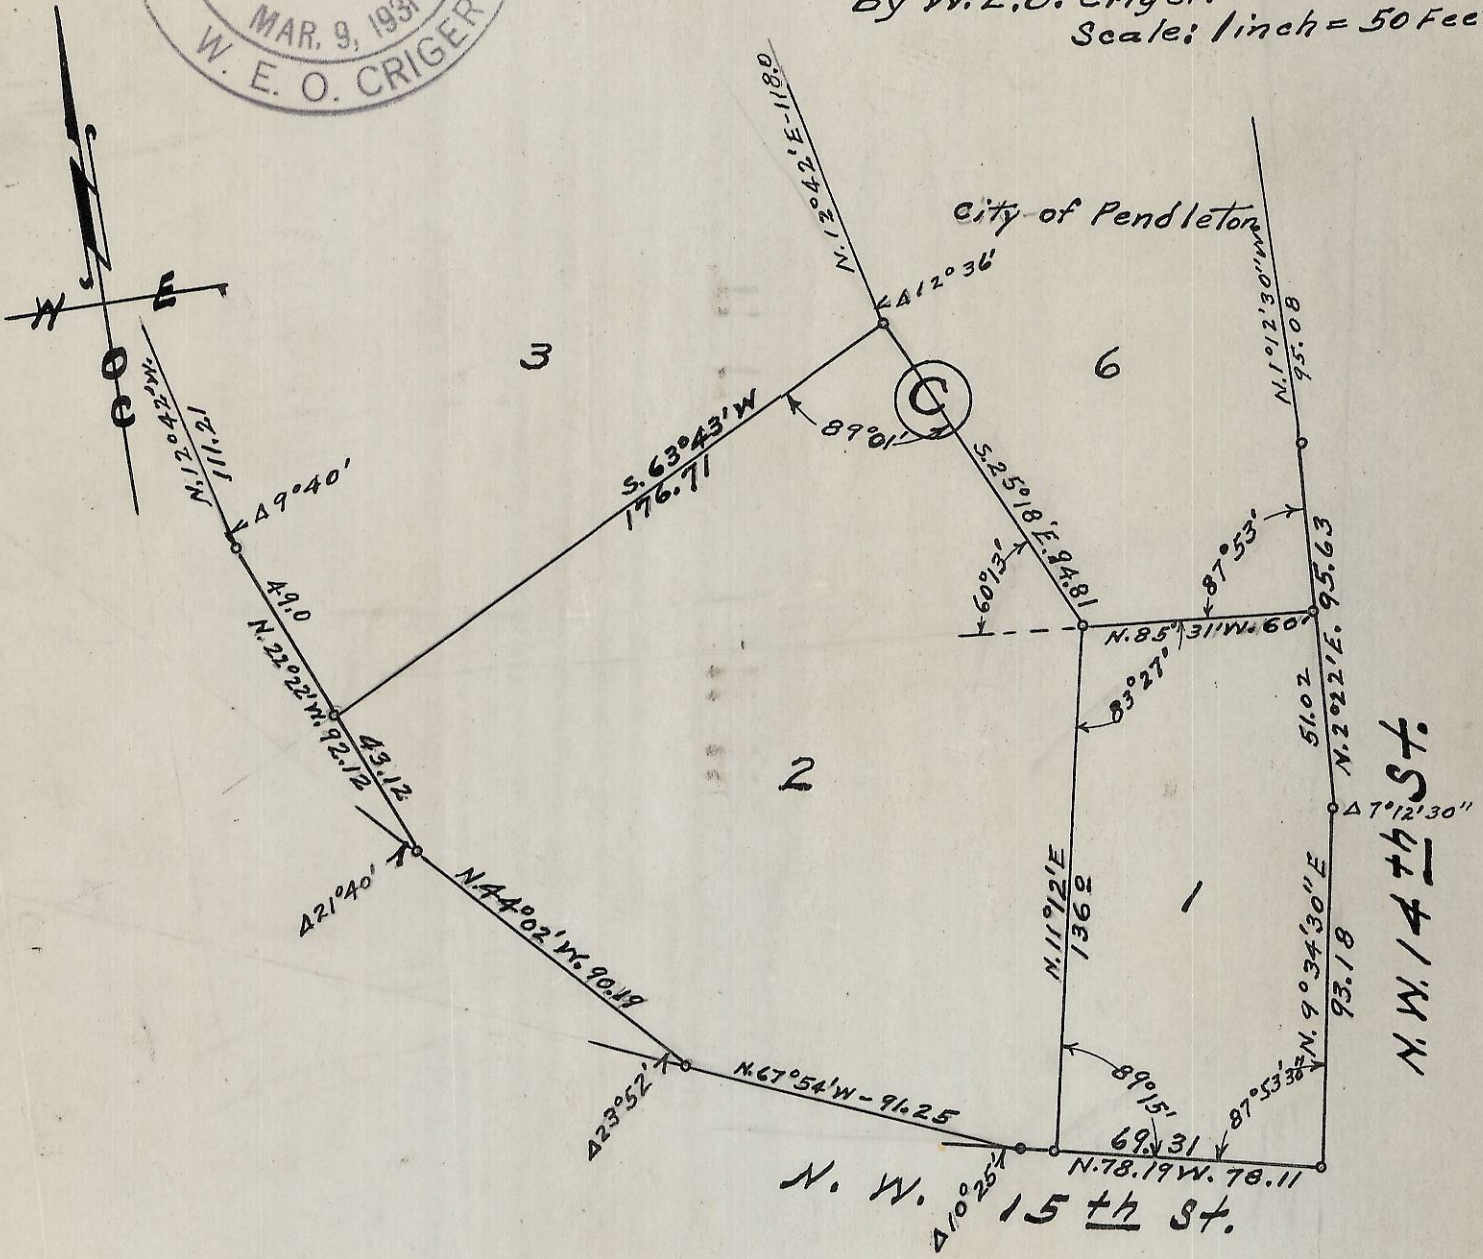

Map showing part of Block "C" of Brown Courts Addition to the City of Pendleton, Oregon. Surveyed, staked & platted March 1950. By W. E. O. Criger.  
Scale: 1 inch = 50 Feet.



06-316-AX