


Plat of
 Block 13 of Reservation Addition
 to the town, now City of Pendleton, Ore.
 surveyed, staked & platted August 1955.
 By W. E. O. Criger -


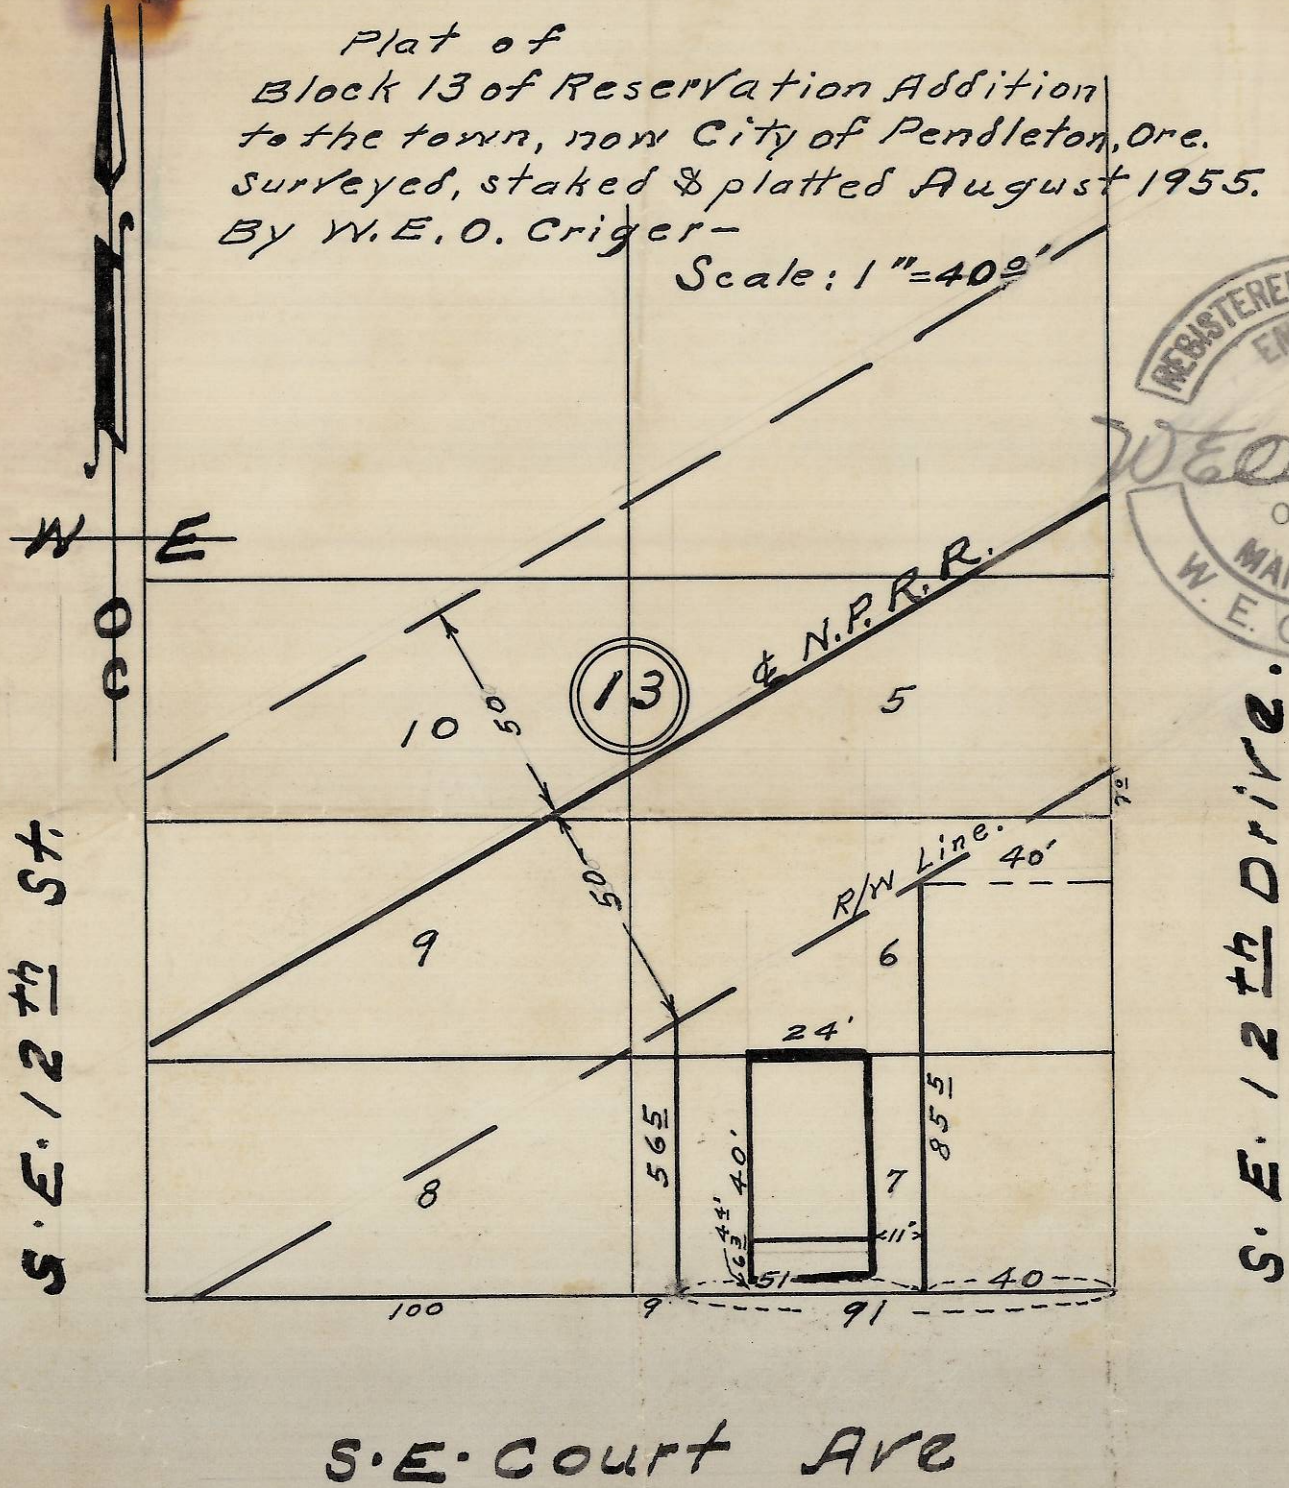

S.E. COURT AVE

06-331-AX

3