


REGISTERED
OREGON
LAND SURVEYOR

Ralph P. Thompson

MAY 13, 1960
RALPH P. THOMPSON
506

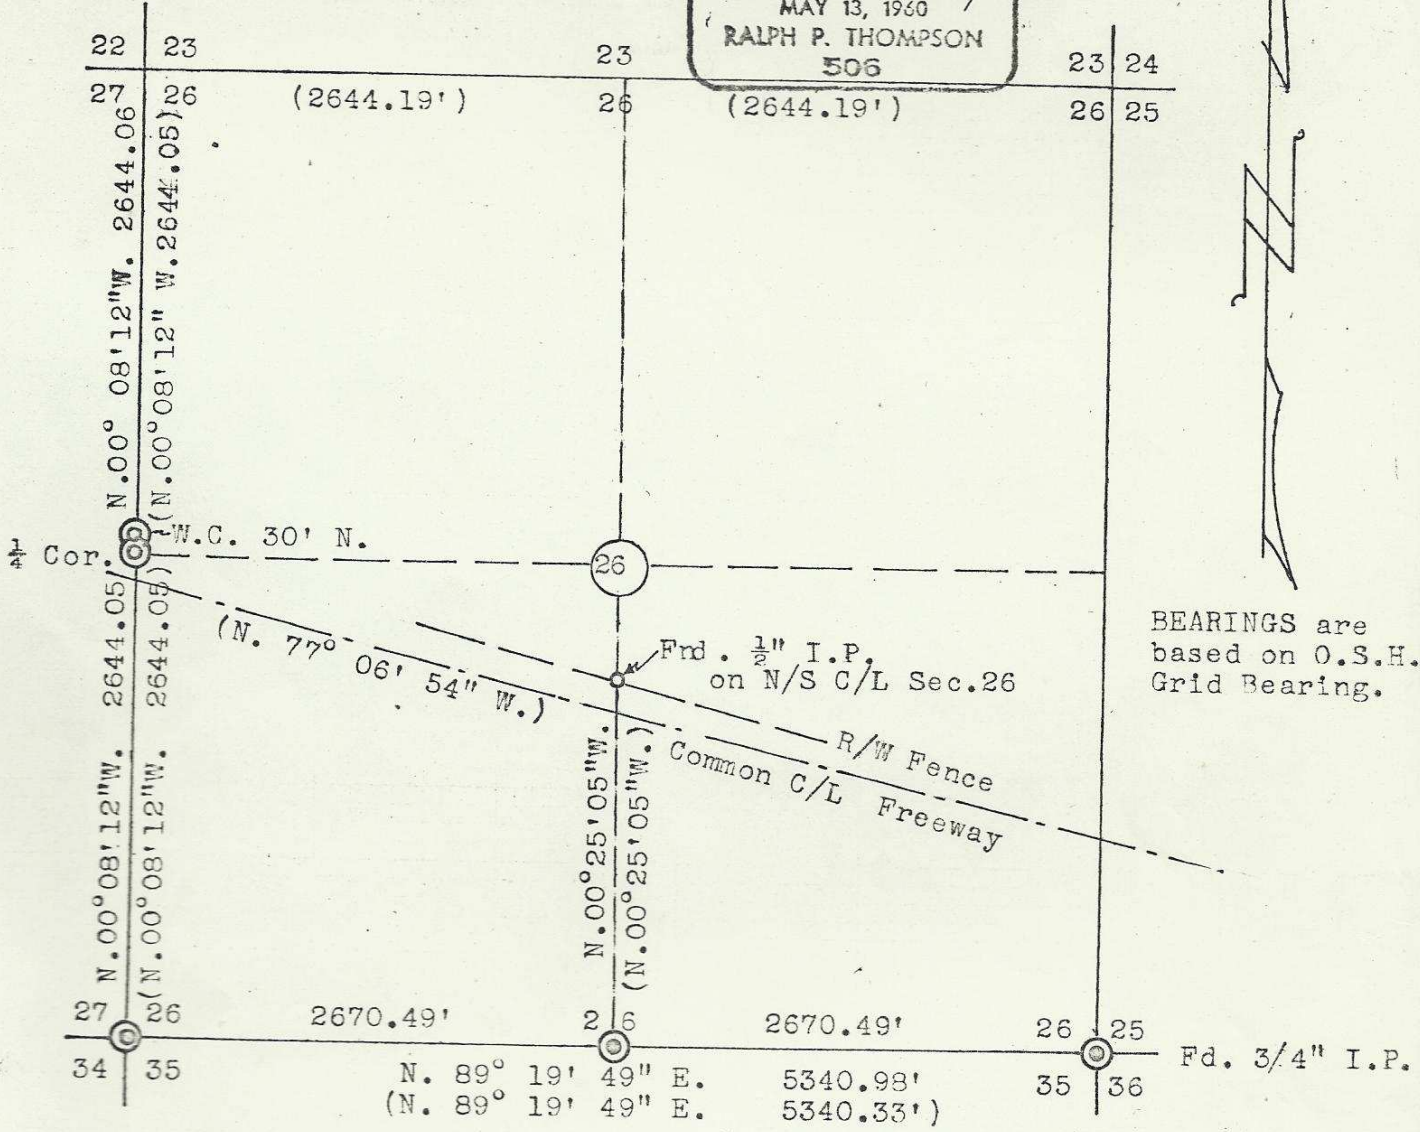

BEARINGS are based on O.S.H. Grid Bearing.


LEGEND

- ⊙ Fnd. B.C. Monument
- Set B.C. Monument
- () Bearings and Distances Per Staebler Survey, 1971

SURVEY FOR STAFFORD HANSELL IN Sec. 26, T.4N. R.27 EWM	
Scale: 1"=1000'	Date: 8-24-71
RALPH THOMPSON	
REGISTERED LAND SURVEYOR	
P. O. BOX 1092 FENDLETON, OREGON 97601	

06-380-Ax

77 Hansell-Brown Survey 11-15-61
T.4 N. R. 27

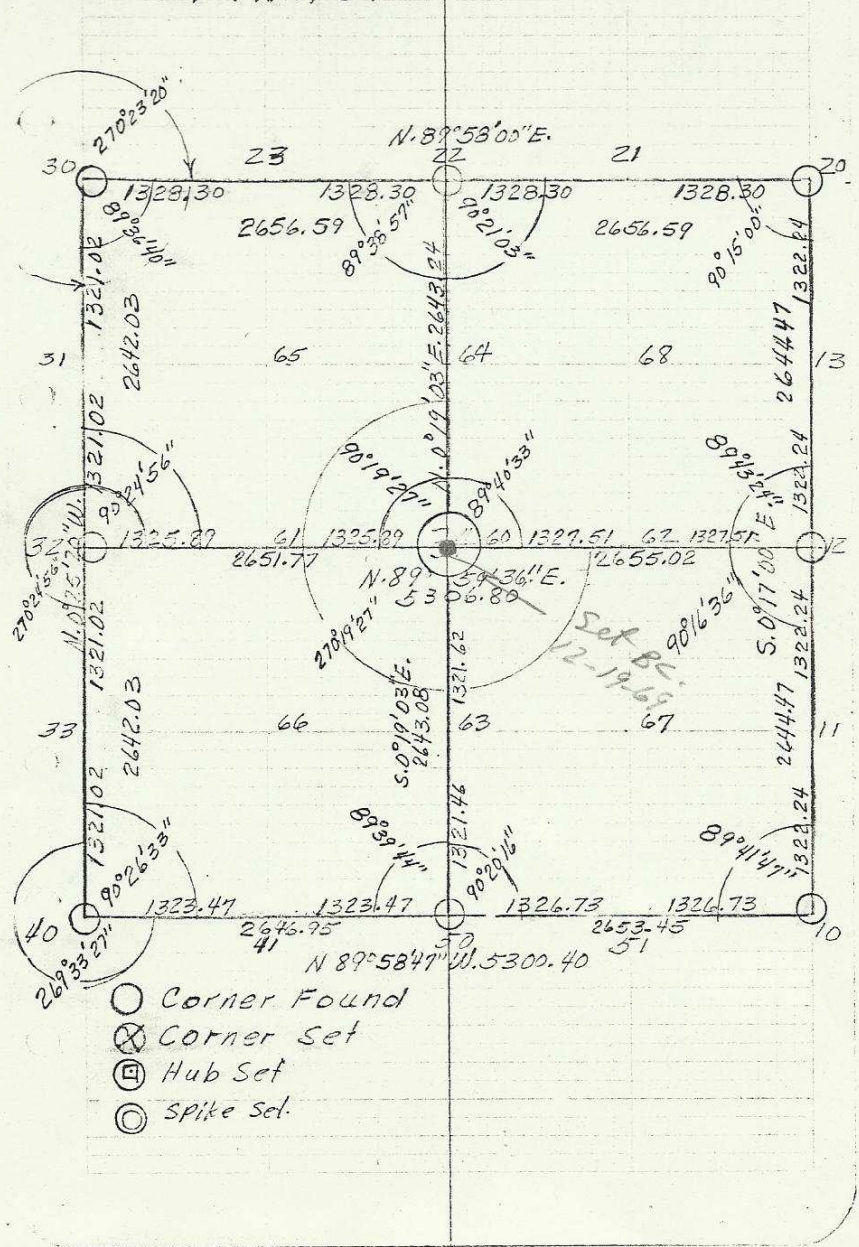

- Corner Found
- ⊗ Corner Set
- ⊠ Hub Set
- ⊙ Spike Set