


NOTE: PROPERTY LINE RUNS THROUGH CENTER OF PLANTER

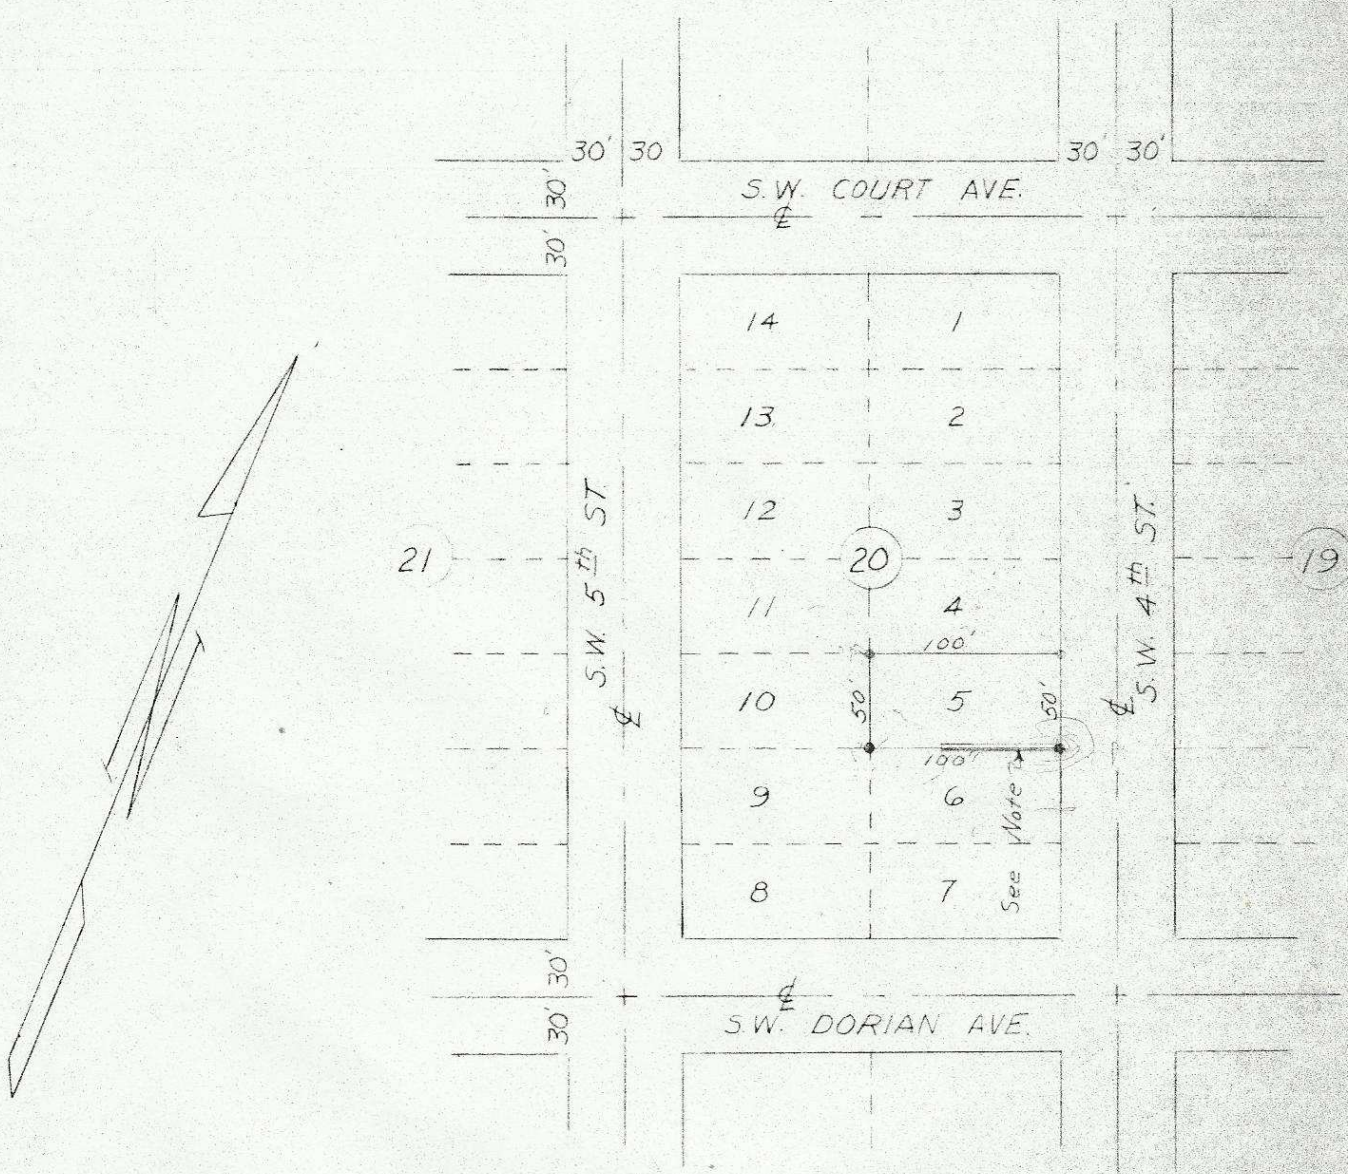

• DENOTES 1/2" IRON PIN SET

2032 104A

REGISTERED
OREGON
LAND SURVEYOR
Leland H. Ascher
LELAND H. ASCHER
635

06-553-AX

HAYES AND HARRIS			
SURVEY FOR			
SOFIA ORTIN			
LOT 5 BLOCK 20			
ARNOLD AND RALEY ADDITION			
PENDLETON, OREGON			
SCALE	DATE	DRN. BY	DRNG. NO.
1"=100'	2-21-65	LHA	65-208