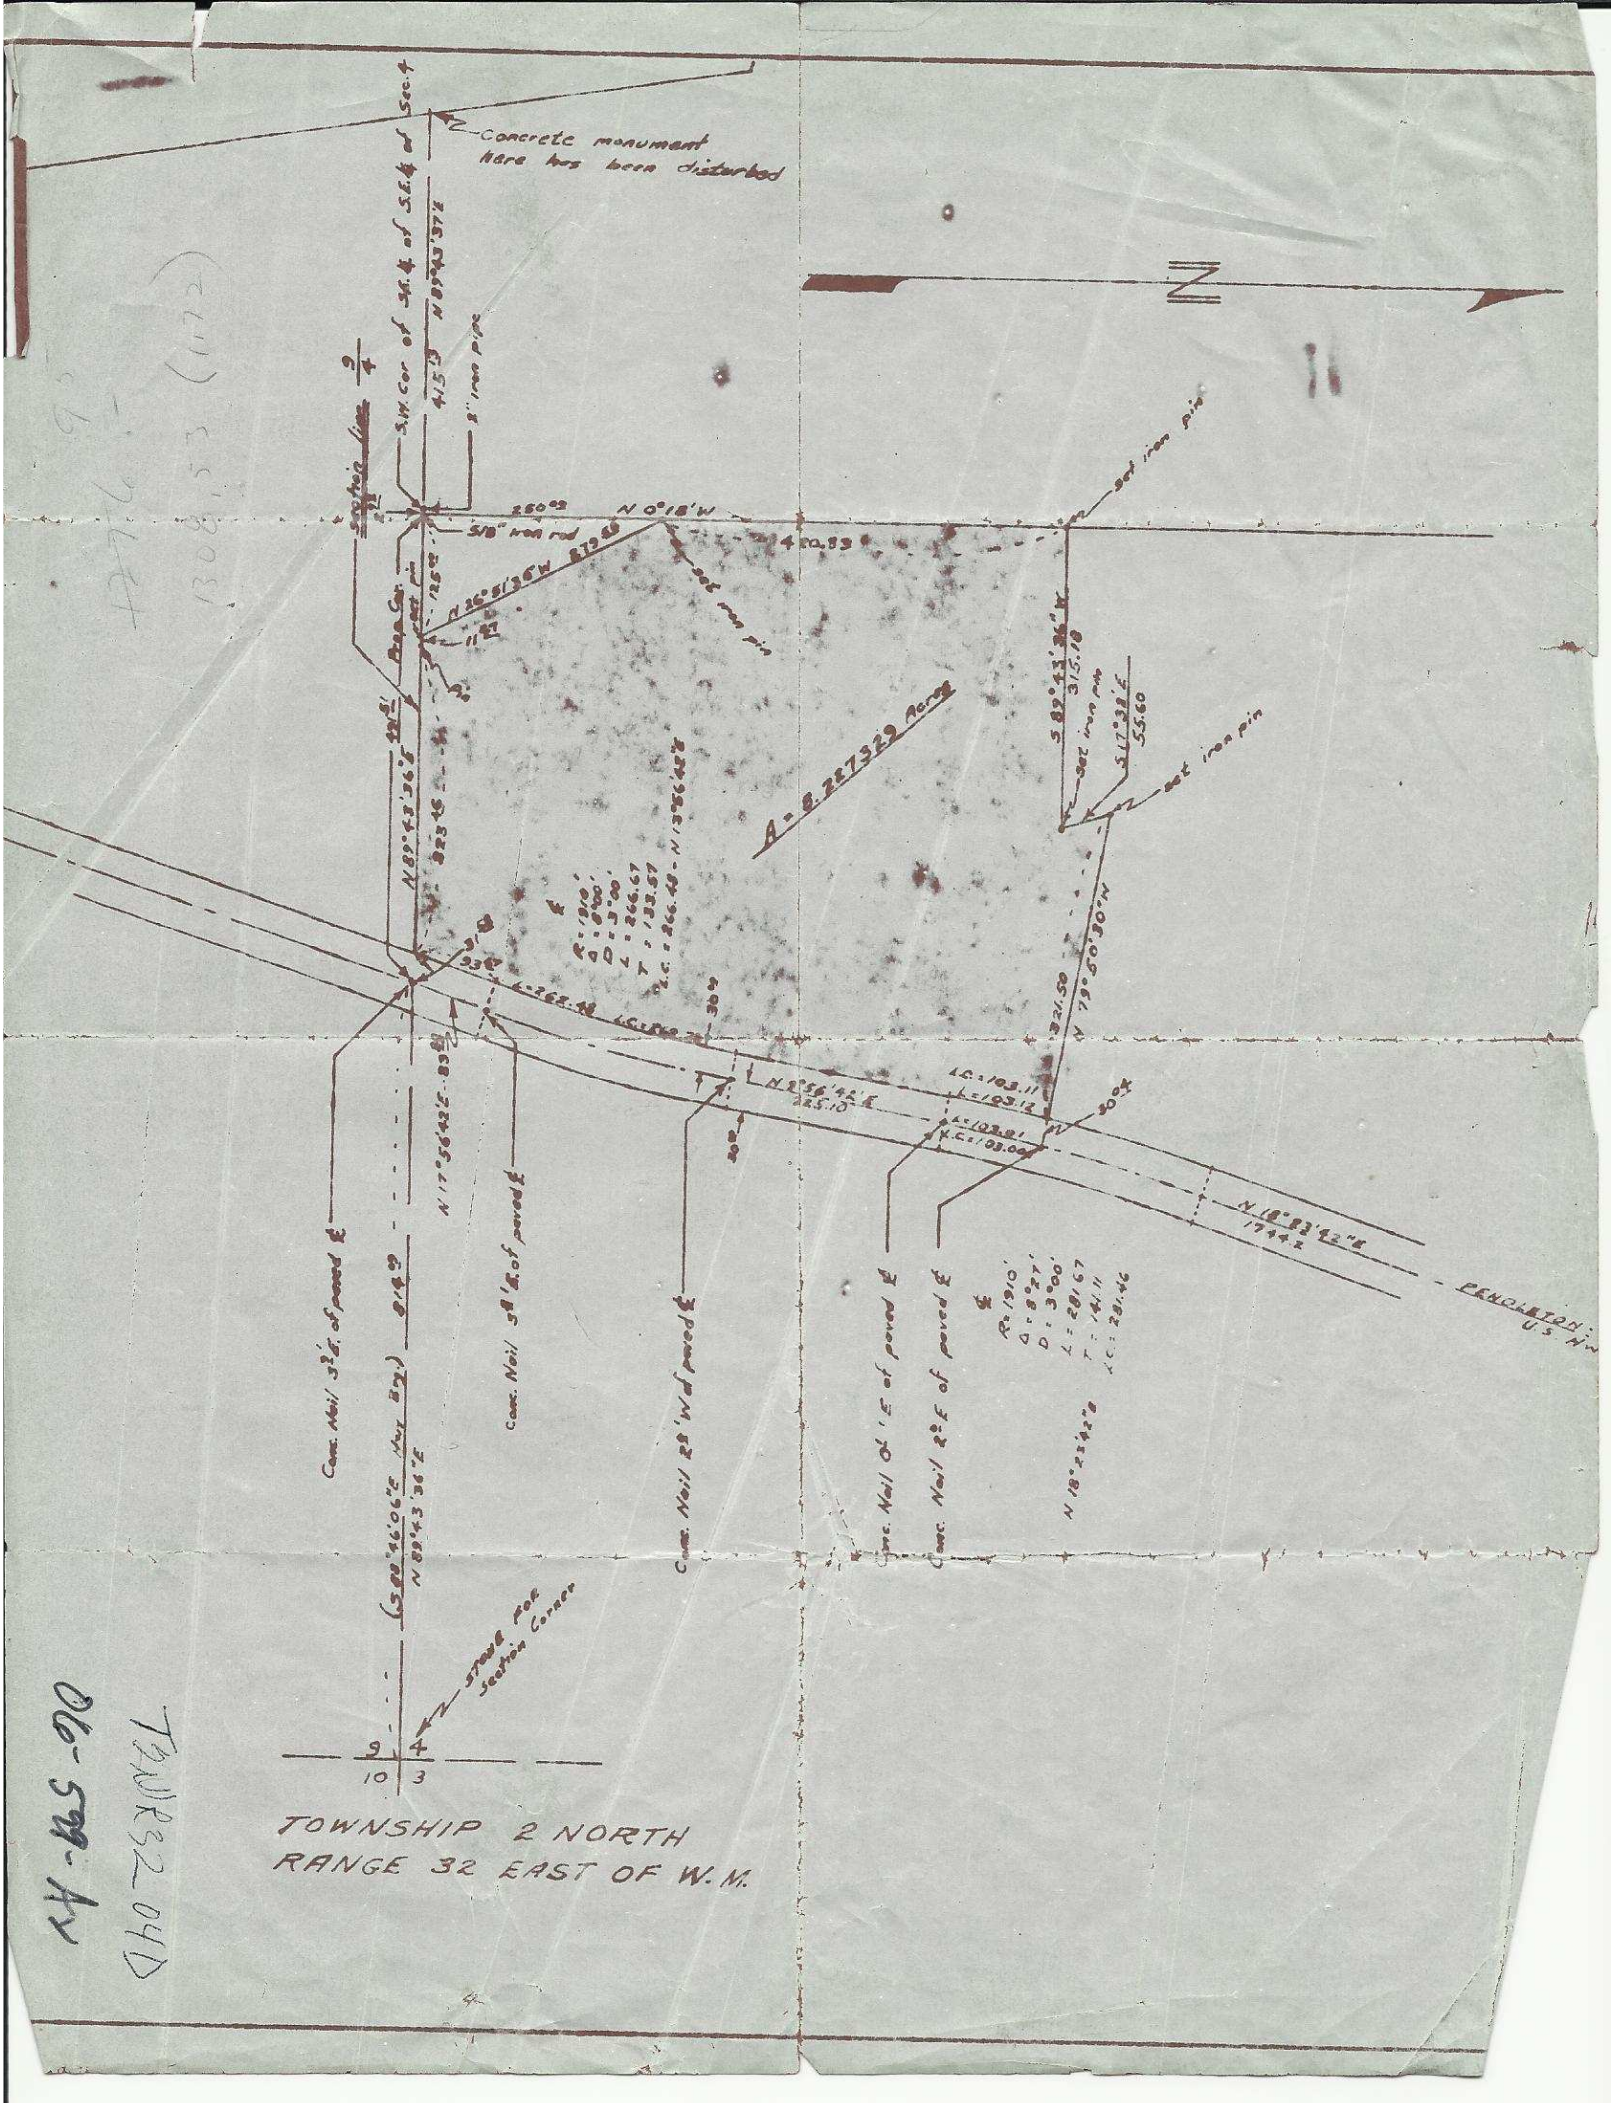
Concrete monument here has been disturbed
S.W. cor. of Sec. 4 of S.E. 1/4 of Sec. 4
2" iron pipe
S 1/4 Sec. Line
5/8" iron rod
N 0°18'W
2600
N 89°42'36"E
N 26°51'36"W
873.68
Conc. Cap
set iron pin
A = 2.227329 Acres
S 82°43'36"E
315.18
S 17°38'E
55.60
N 19°50'30"W
321.50
R = 1910'
Δ = 8°27'
D = 3°00'
L = 266.67
T = 133.57
L.C. = 266.43
N 13°36'42"E
L = 262.78
L.C. = 262.78
N 8°56'42"E
225.10
L.C. = 103.11
L = 103.12
N 18°23'42"E
174.42
PENDLETON
U.S. Hwy
Conc. Nail 3'E. of pvmt. E
S 89°36'06"E
N 89°43'36"E
Conc. Nail 9'E. of pvmt. E
Conc. Nail 28' W. of pvmt. E
Conc. Nail 0.1'E. of pvmt. E
Conc. Nail 22'E. of pvmt. E
R = 1910'
Δ = 8°27'
D = 3°00'
L = 281.67
T = 141.11
L.C. = 281.46
N 18°23'42"E
Stone for Section Corner
9
4
10
3
TOWNSHIP 2 NORTH
RANGE 32 EAST OF W.M.
T2N R32 E
04D
Y-85-20