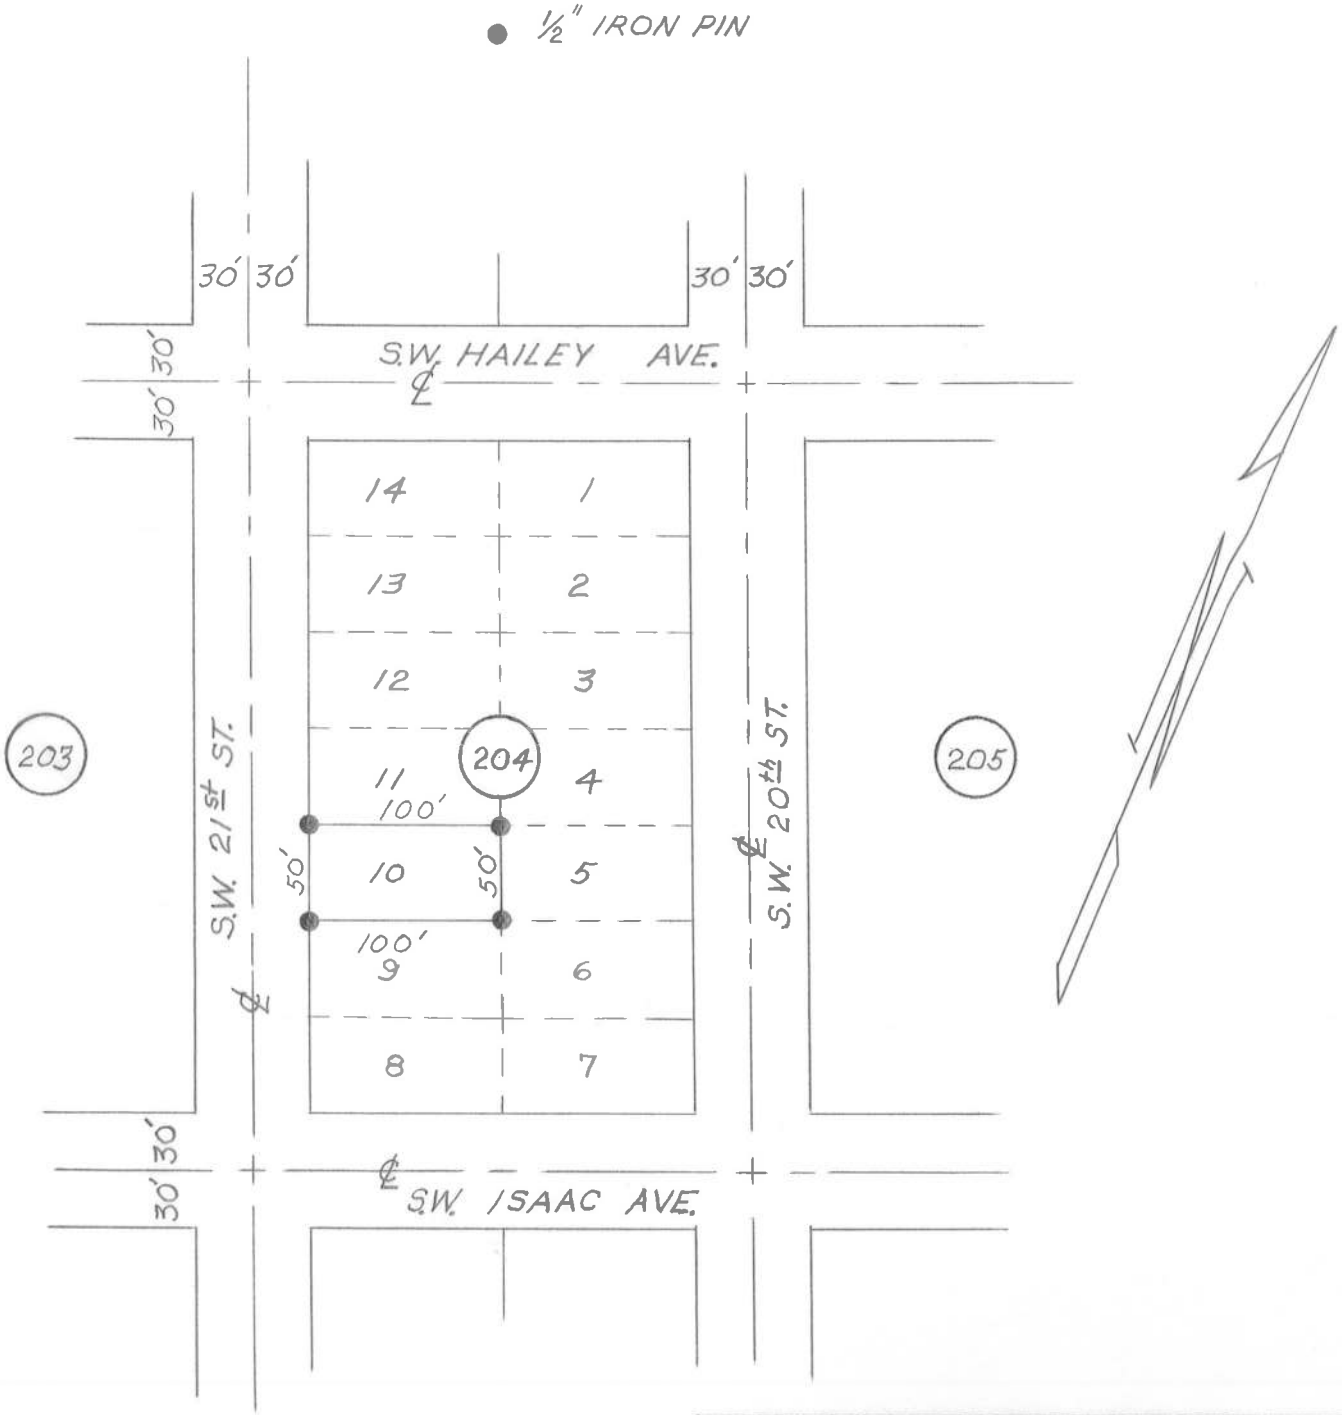


REGISTERED
OREGON
LAND SURVEYOR

James E. Bussard

JULY 12, 1963
JAMES E. BUSSARD
599

14-079-Ax

HAYES AND HARRIS

SURVEY FOR

L.T. FISHER

LOT 10 BLOCK 204
RESERVATION ADDITION
PENDLETON, OREGON

| SCALE | DATE | DRN. BY | DRNG. NO. |
|---|---|---|---|
| 1"=100' | 11/6/63 | JEB | 63-183 |