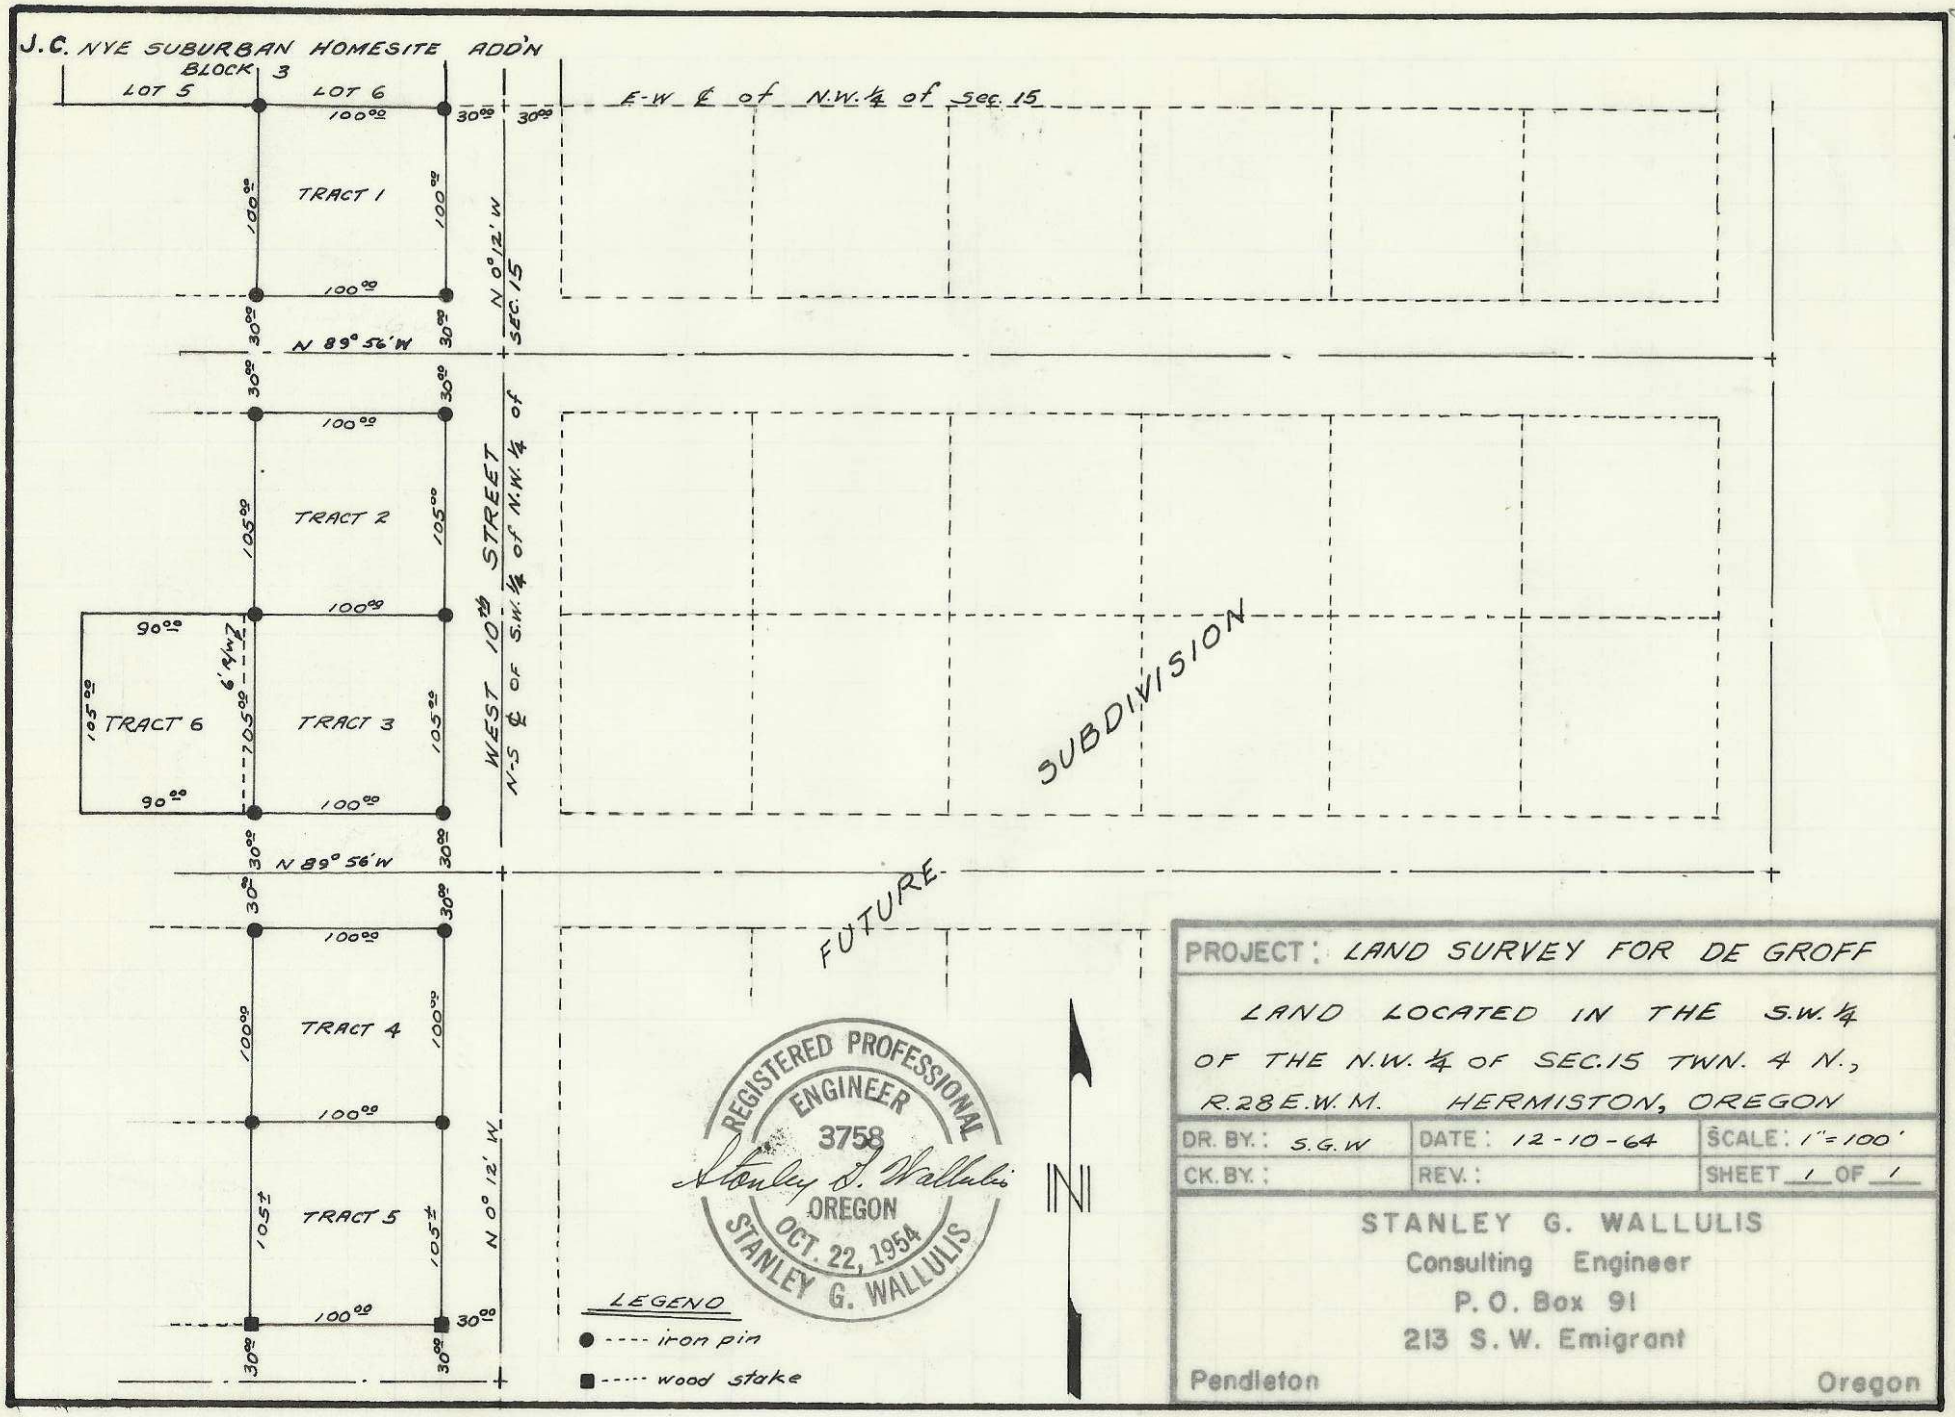

PROJECT: LAND SURVEY FOR DE GROFF

LAND LOCATED IN THE S.W. ¼ OF THE N.W. ¼ OF SEC. 15 TWN. 4 N., R. 28 E.W.M. HERMISTON, OREGON

DR. BY.: S.G.W	DATE: 12-10-64	SCALE: 1"=100'
CK. BY.:	REV.:	SHEET 1 OF 1

STANLEY G. WALLULIS
Consulting Engineer
P. O. Box 91
213 S. W. Emigrant
Pendleton Oregon

A-5-A

A-5