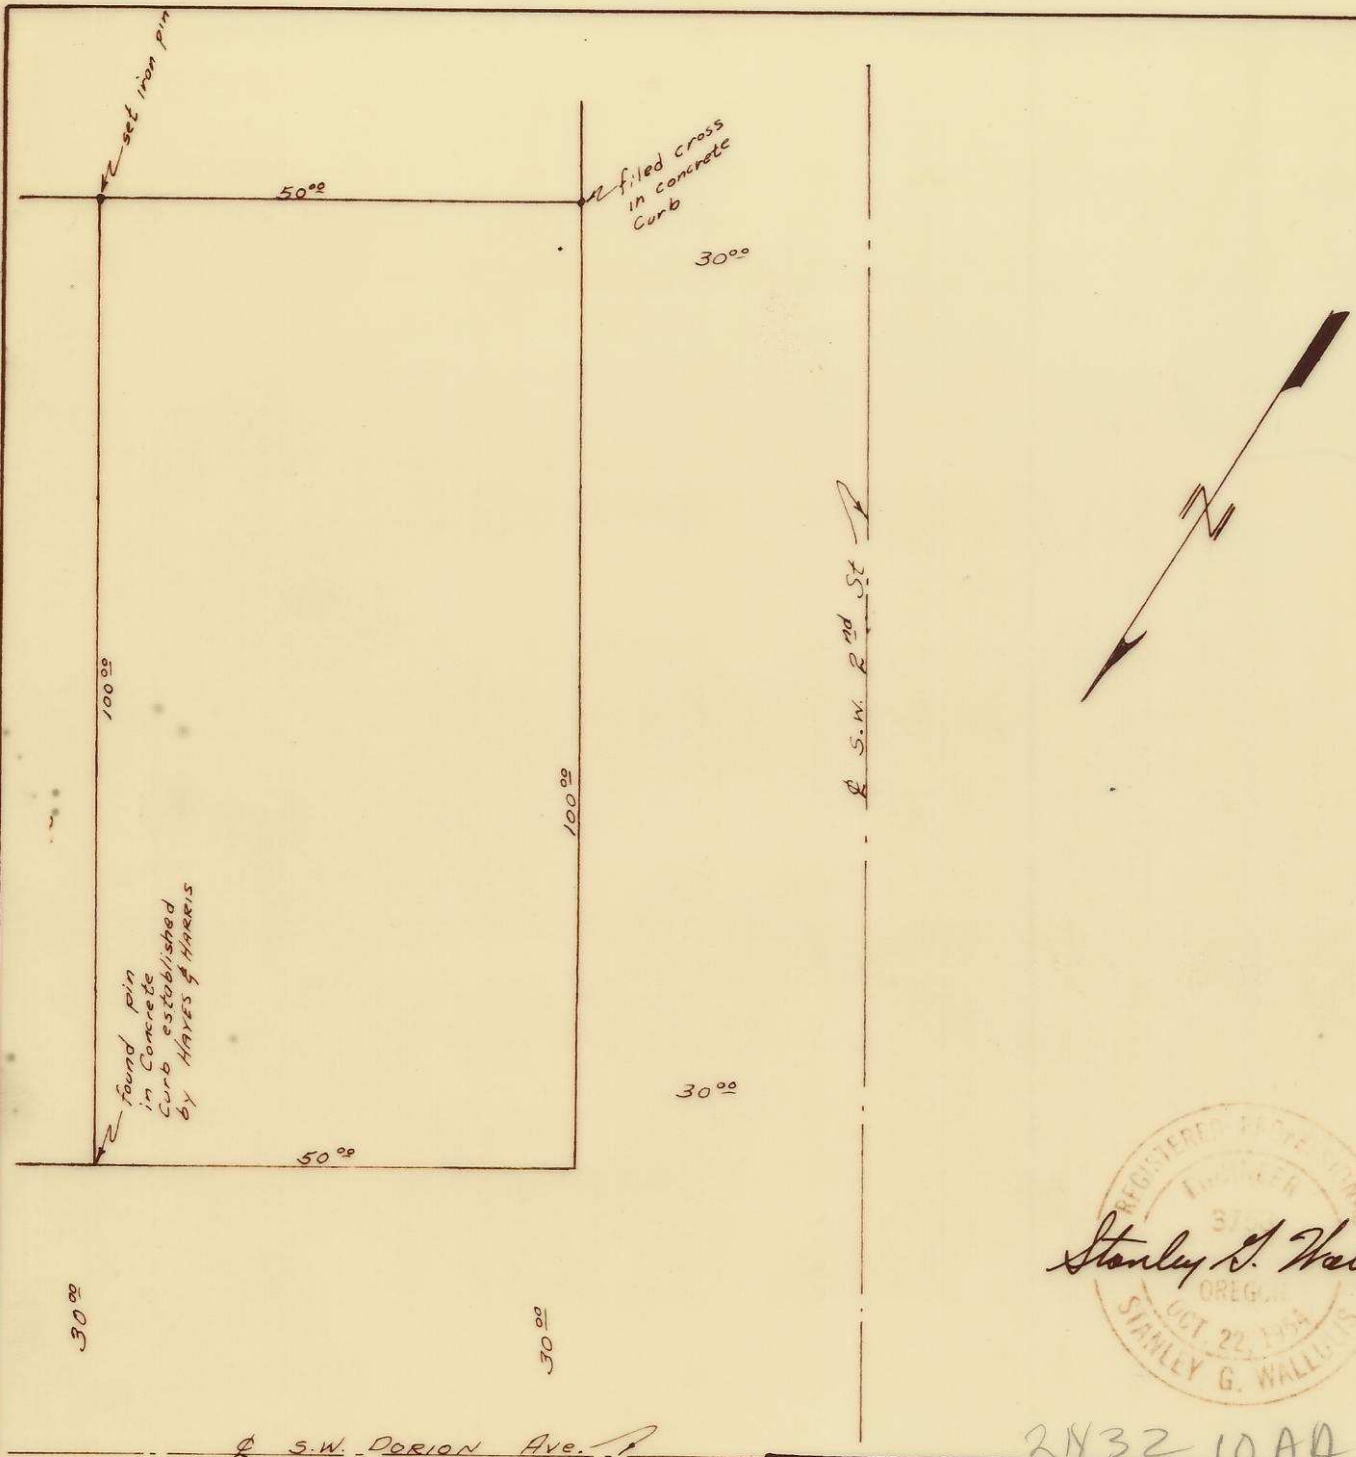

REGISTERED PROFESSIONAL ENGINEER
STATE OF OREGON
OCT. 22, 1965
STANLEY G. WALLULIS

Stanley G. Wallulis

2N32 10AA

PROJECT: LOT SURVEY		
FOR WESLEY V. KORMAN In Pendleton, Oregon		
DR. BY.: S.G.W.	DATE: 8-4-65	SCALE: 1" = 20'
CK. BY.: S.G.W	REV.:	SHEET 1 OF 1

STANLEY G. WALLULIS
Consulting Engineer
P. O. Box 91
213 S. W. Emigrant
Pendleton Oregon

A-30-AX