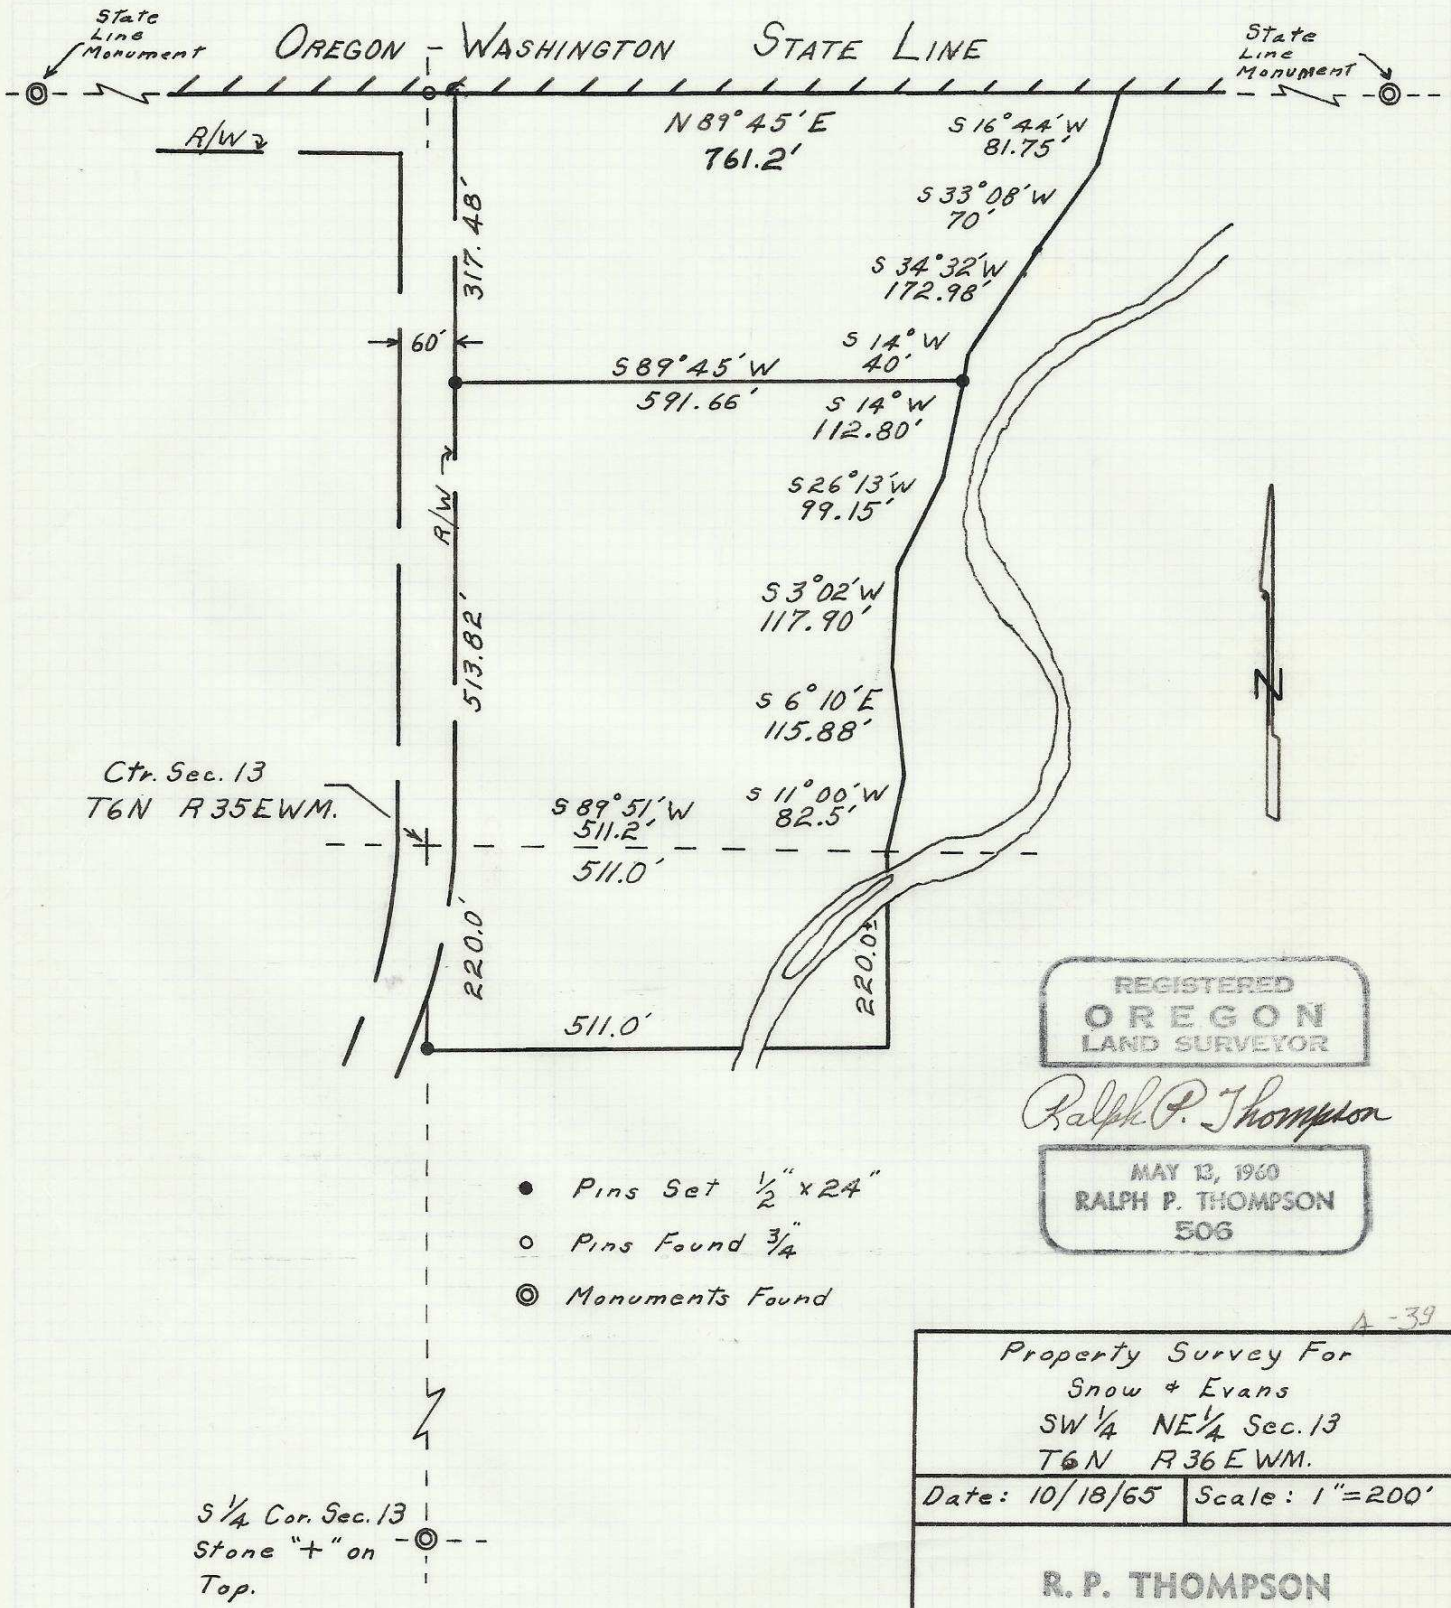

REGISTERED
OREGON
LAND SURVEYOR
Ralph P. Thompson
MAY 13, 1960
RALPH P. THOMPSON
506

A-39

Property Survey For
Snow & Evans
SW ¼ NE ¼ Sec. 13
T6N R36E WM.

Date: 10/18/65 | Scale: 1"=200'

R. P. THOMPSON
REGISTERED PROFESSIONAL LAND SURVEYOR
13 S. E. COURT AVE. PENDLETON, OREGON

A-39

A-39-A x